

CERTIFIED LAND CORNER RESTORATION

State of Wisconsin }
County of Oneida } ss.

I, James D. Rein, do hereby certify that on the 28th day of August, 1979, I found evidence of the Section corner of 28, 29, 32 & 33 Township 37 North, Range 8 East, Fourth Principal Meridian, as described hereon; and that from this evidence I established a new monument and accessories as described hereon to perpetuate the original location of this corner:

Description of original monument and accessories and subsequent restorations:

Wood post set by William E. Dougherty, Deputy Surveyor July 22, 1863, witnessed by a 7" Aspen S30°E, 43 lks (28.38 feet) and by a 10" Aspen N71°W, 31 lks (20.46 feet) Earl C. Harrington, U.S. Cadastral Engineer, September, 1927 re-established true position of corner by double proportionate measurement between nearest identified corners. No monument was set to mark position.



Description of corner evidence found:

No evidence of a monument was found at true corner position as re-established by double proportionate measurement using the same nearest identified corners as G.L.C. in 1927. A partially decayed unscribed oak post bears S57°-38'E, 8.97 feet from true position.

Description of monument and accessories I established to perpetuate the location of this corner:

At the true position I set an Aluminum Oneida County Survey Marker, 2 inches in diameter and 30 inches long with 3-1/4" diameter cap, 22 inches in the ground. Made bearing trees with r.k. nails set in lower blaze as follows:

- 5" maple N80°W 18.94 feet
- 9" oak S26°W, 30.21 feet
- 9" oak S74°E, 31.99 feet

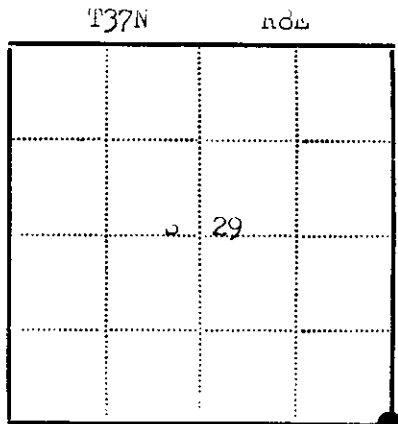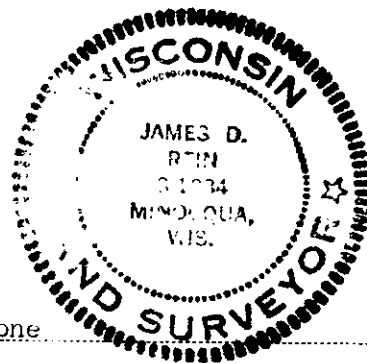

● - Corner monument restored
□ -

Resident witnesses none

Dated at minoqua Wisconsin, this 10th day of September 1979.

Signature James D. Rein Title Land Surveyor
(County Surveyor, Registered Land Surveyor, or other duly authorized official)

Surveyors Registration No. 5-1234

Office of REGISTER OF DEEDS County of Oneida

I hereby certify that the within instrument was filed in this office for record on the 17th day of September 1982, and was filed in Book No. _____ Page No. _____ of County Records.

Signature Loris Verge Kuehn Title REGISTER OF DEEDS

Township _____, Range _____, Section _____, Index No. _____, Page No. _____

3708290000

7-9