

### CERTIFIED LAND CORNER RESTORATION

State of Wisconsin }  
County of Oneida } ss.

I, James D. Rein, do hereby certify that on the 19th day of April, 1979, I found evidence of the original meander corner of between sections 29 and 32 Township 37 North, Range 8 East, Fourth Principal Meridian, as described hereon; and that from this evidence I established ~~a new monument and~~ accessories as described hereon to perpetuate the original location of this corner:



\*Original record 24.09 chs. west of the corner of sections 28, 29, 32 and 33.  
Description of original monument and accessories and subsequent restorations: wood post set by William E. Dougherty, Deputy Surveyor, July 24, 1863, witnessed by a 5" birch N55°E, 27 lks (17.82 feet) and by a 25" white pine S34°E, 32 lks (21.12 feet) iron post set by Earl G. Harrington, U.S. Cadastral Engineer, September, 1927, witnessed by original 30" diameter pine stump S34°E, 32 lks (21.12 feet)

#### Description of corner evidence found:

G.L.C. brass capped 1-3/4" inside diameter iron pipe up 1 foot and 7 feet east of waters edge.  
Original pine stump is now gone.

#### Description of ~~monument and~~ accessories I established to perpetuate the location of this corner:

filed stones around monument.  
made bearing trees with R.K. nails set in lower blaze as follows:  
13" Soft maple S46°E, 21.33 feet  
13" white birch S86°E, 24.62 feet  
9" white birch N58°E, 34.10 feet

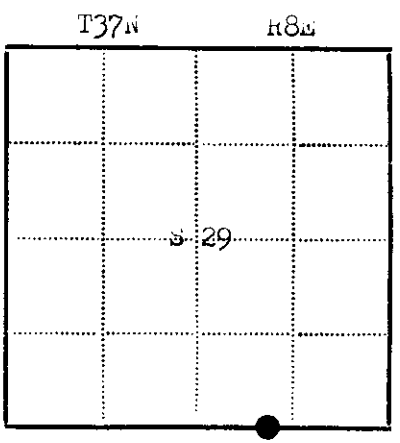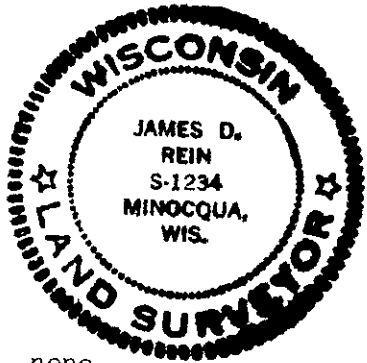

● - Corner monument restored  
□ -

Resident witnesses none

Dated at Minocqua Wisconsin, this 10th day of September 1979:

Signature James D. Rein Title Reg. Land Surveyor  
(County Surveyor, Registered Land Surveyor, or other duly authorized official)

Surveyors Registration No. S-1234

Office of REGISTER OF DEEDS County of Oneida

I hereby certify that the within instrument was filed in this office for record on the 17th day of September 1982, and was filed in Book No. \_\_\_\_\_ Page No. \_\_\_\_\_ of County Records.

Signature Loris Verage Kuehn Title REGISTER OF DEEDS

Township \_\_\_\_\_, Range \_\_\_\_\_, Section \_\_\_\_\_, Index No. \_\_\_\_\_, Page No. \_\_\_\_\_

3708290012

U-8