

This form is intended to fulfill the requirements of Chapter A-E 7.08 (3)(a) thru (i) U.S. Public Land Survey Monument Location Record, Wisconsin Administrative Code. Use the reverse side of form for continuation.

U.S. PUBLIC LAND SURVEY MONUMENT LOCATION RECORD

USPLS CORNER: NORTH WITNESS MC SECTION: 28 TOWNSHIP: 37 NORTH RANGE: 8 EAST

NAME OF WATERWAY FOR M.C. CORNER: SHERRY LAKE SECTION LINE: WEST

~~(CITY)(VILLAGE)(TOWN)~~ OF: NEWBOLD COUNTY OF: ONEIDA

Description of monument found or placed and all other evidence used as the basis for monument location; including monuments and related measurements required if the corner location was reestablished by lost corner proportionate methods. Also indicate name of original surveyor, original survey date and the corner monument, bearing trees, witness or other reference monuments established; including measured bearing and distance ties, from available records.

Found and accepted an old 1.5" dia. galvanized iron pipe with uncapped top 8" up and tipped slightly to South; I pulled the 26" long iron pipe and drove a standard 2" dia. x 30" long aluminum pipe monument with stamped Oneida County cap 1" up into plumb soil cavity left by the old iron pipe below grade. Corner falls 5' +/- North of existing lakeshore bearing S70°W this date. I left old iron pipe flat on grade nearby.

In July 1863, William E. Daugherty/GLO set a wood post as the original corner and marked OBTs: a 15" Py N04°E 6 links and an 8" Py S70°W 12 links; all are now considered obliterated beyond practical recovery usage.


In September 1925, C.D. Vaughan notes MC found and stumps of OBTs; also a new 10" Py BT SW but no distance noted per Page 49 of Old Field Book 38 in Oneida County survey records.

In January 1956, Ivan Branham notes MC set on North side of Perenish Lake, now known as Sherry Lake, per Page 44 of Branham Book 3 field notes in Oneida County survey records; no BTs noted.

In March 1958, Sy M. Poskie/RLS 140 notes a circle symbol as MC at this corner location per Plat of Survey filed as A-513 in Oneida County survey records; and also again in 1963, 1964 and 1974 per Plats of Survey filed as A-449, B-1820, L-888 and L-950 in Oneida County survey records; no BTs noted.

This recovery completed October 17, 2002; there were no direct witnesses.

Plan view map of monument location with bearing and distance ties to a minimum of four(4) described witness or reference monuments of concrete, natural stone, iron, live bearing trees or equivalent material. If applicable, also show a minimum of two(2) bearing and distance ties to any other monument found and not accepted; including the bearing and distance from the accepted monument.

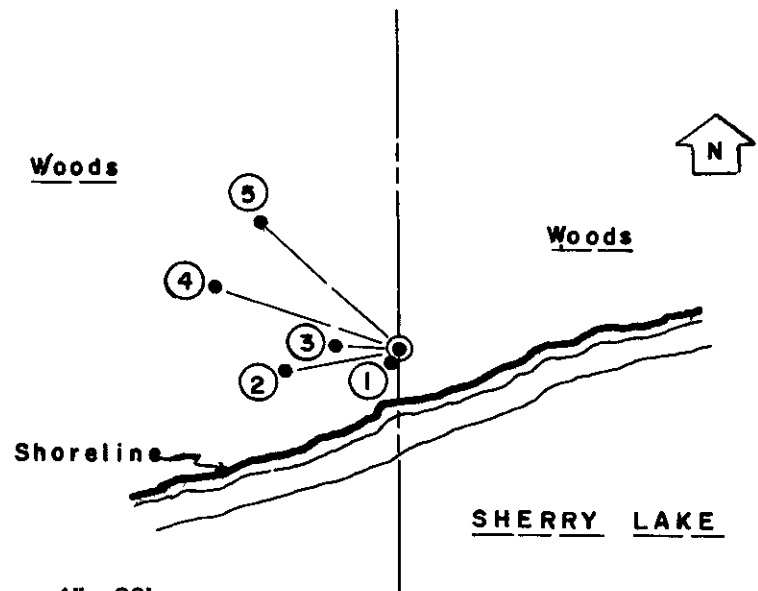

WITNESS MONUMENT TIES:


- ① New 8" Bw BT tipped 25°+- SE S40°W 1.30'; no PK/W set in face.
- ② New 7" Pw BT S80°W 11.90'.
- ③ New 4" Mr BT N85°W 6.60'.
- ④ New 12" Oak BT N70°W 20.20'.
- ⑤ New 4.5" Pw BT N46°W 19.55'.

Standard white poly 'T' marker post set 4" North of corner monument.

SCALE: 1" = 20'

Unless otherwise indicated, all bearing tree ties are to a .25" dia. by 2.5" long PK nail with a 1.25" dia. steel washer driven into unblazed right face and a .25" dia. by 2.5" long PK nail with a 2" dia. steel washer stamped BT is also driven into unblazed face of bearing tree at DBH; the basis for measured bearings is by compass to nearest degree and all tie distances are measured horizontal by steel tape corrected to nearest 1/100th feet at standard temperature of 68° F.


RLS SEAL:

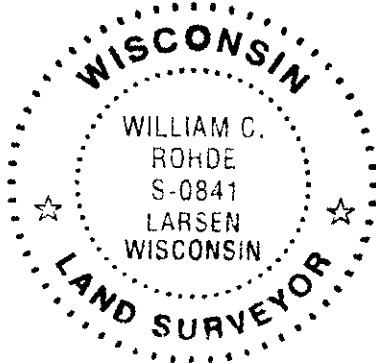

LAND SURVEYOR CERTIFICATE:

I, William C. Rohde, hereby certify that I am duly licensed as a Professional Land Surveyor in the State of Wisconsin; that this USPLS monument location was determined by me and/or under my direct supervision and control; and that this U.S. Public Land Survey Monument Location Record is true and correct to the best of my knowledge and belief.

Signed: *William C. Rohde*
William C. Rohde RLS 841

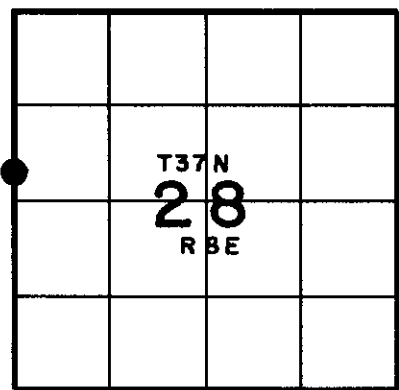

SECTION LOCATION MAP

INDEX NO. ST 9

3708292200