

CERTIFIED LAND CORNER RESTORATION

State of Wisconsin }
County of Oneida } ss.

I James D. Rein, do hereby certify that on the 2nd day of April, 1979, I found evidence of the Southeast corner of Section 30 Township 37 North, Range 8 East, Fourth Principal Meridian, as described hereon; and that from this evidence I established new monument and accessories as described hereon to perpetuate the original location of this corner:

Description of original monument and accessories and subsequent restorations:


wood post set by William E. Dougherty, Deputy Surveyor on July 24, 1863, witnessed by 10" aspen S68°E, 30 lks (19.80 feet), 9" Birch N62°W, 15 lks (9.90 feet)
Corner found by D. H. Vaughn, County Surveyor on January 12th, 1899.
F. H. Vincentsen, County Surveyor on September 11, 1948 described corner as being monumented by an iron pipe, witnessed by an 8" aspen S32°W, 15 lks (9.90 feet), 14" pine, N1°E, 32 lks (21.12 feet)

Description of corner evidence found:


3/4" diameter iron pipe up 1 foot, witnessed by an 11" Poplar (dead), S32°W, 9.6 feet, 16" Jack pine N1°E, 21.15 feet.

Description of monument and accessories I established to perpetuate the location of this corner:

made ties to the existing 3/4" diameter iron pipe as follows:
Set P.N. nail in existing bearing tree, 16" Jack pine N1°E, 21.15 feet
made bearing trees with P.N. nails set in lower blaze as follows:
13" Jack pine N74°W, 67.87 feet
18" Norway pine S79°W, 69.90 feet.

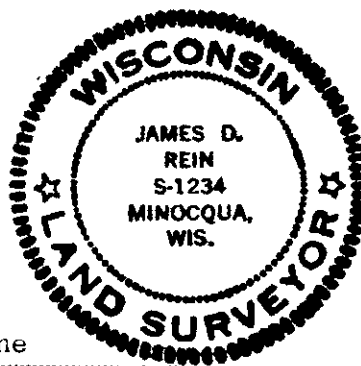

Section 30, T37N, R8E

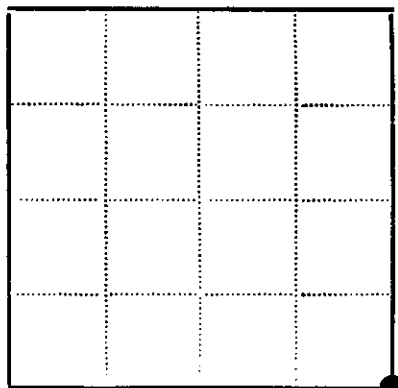

● - Corner monument restored
□ -

Resident witnesses none

Dated at Minocqua, Wisconsin, this 10th day of September, 1979.

Signature [Handwritten Signature] Title Reg. Land Surveyor
(County Surveyor, Registered Land Surveyor, or other duly authorized official)

Surveyors Registration No. S-1234

Office of REGISTER OF DEEDS County of Oneida

I hereby certify that the within instrument was filed in this office for record on the 17th day of September, 1982, and was filed in Book No. Page No. of County Records.

Signature [Handwritten Signature] Title REGISTER OF DEEDS

Township, Range, Section, Index No., Page No.

3708300000

1-5