

CERTIFIED LAND CORNER RESTORATION

State of Wisconsin }
County of Oneida } ss.

I, James D. Rein, do hereby certify that on the 9th day of April, 1979, I found evidence of the East One-quarter corner of Section 30 Township 37 North, Range 8 East, Fourth Principal Meridian, as described hereon; and that from this evidence I established ~~a new monument and~~ accessories as described hereon to perpetuate the original location of this corner:

Description of original monument and accessories and subsequent restorations:

Wood Post set by William E. Dougherty, Deputy Surveyor on July 24th, 1863, witnessed by a 6" aspen bearing S19°W, 16 links (10.56 feet), 7" aspen N53°E, 4 links (2.63 feet). D. N. Vaughn, County Surveyor, January 1899 found original bearing trees, Orig. Aspen is a white pine made bts 16" aspen stub SW 14-1/2 links (9.57 feet), 8" birch S79°W 14 links (9.24 feet). P. K. Vincentsen, County Surveyor, September 11th, 1948 D. N. Vaughn's 1/4 corner 5" x 5" post BT 7" pine S66°E, 45.5 lks (30.03 feet), 6" oak N78°W, 44.75 lks (29.54 feet)

Description of corner evidence found:


1" diameter galvanized iron pipe up 1 foot on the north edge of an east-west logging trail, witnessed by the following bearing trees:

- 9" oak N78°W, 28.93 feet
- 12" white pine S66°E, 29.25 feet
- 14" Norway pine S40°E, 51.31 feet


Description of ~~monument and~~ accessories I established to perpetuate the location of this corner:

Made ties to the existing 1" diameter iron pipe by setting P.K. nails in the existing bearing trees as follows:

- 9" oak N78°W, 28.93 feet
- 12" white pine S66°E, 29.25 feet
- 14" Norway pine S40°E, 51.31 feet

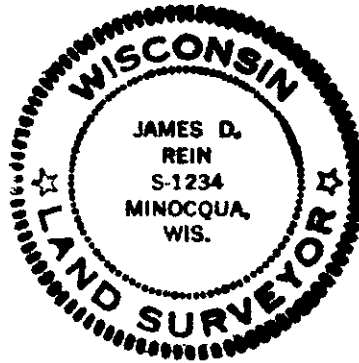

Section 30, T37N, R8E

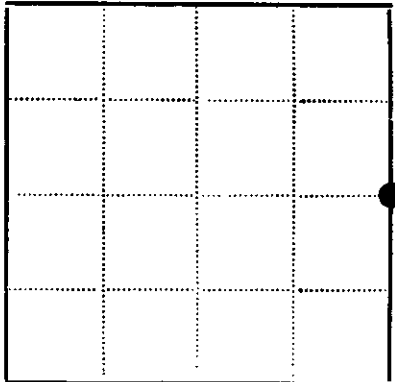

● - Corner monument restored
□ -

Resident witnesses none

Dated at Minocqua Wisconsin, this 10th day of September, 1979.

Signature James D. Rein Title Reg. Land Surveyor
(County Surveyor, Registered Land Surveyor, or other duly authorized official)

Surveyors Registration No. S-1234

Office of REGISTER OF DEEDS County of Oneida

I hereby certify that the within instrument was filed in this office for record on the 17th day of September, 1982, and was filed in Book No. Page No. of County Records.

Signature Toris Verge Kuehn Title Register of Deeds

Township, Range, Section, Index No., Page No.

3708307000

