


U.S. PUBLIC LAND SURVEY MONUMENT RECORD

Note: This form is intended and designed to fulfill all requirements of Wisconsin Administrative Code, Chapter A-E 5.02, U.S. Public Land Survey Monument Record (3) (a) (b) (c) (d) (e) (f) (g) (h) (i). An additional sheet may be added if necessary to conform with said requirements.

(a) Corner location: Township 37 North
 Range 8 East/West

Town/City/Village Newbold

County Oneida

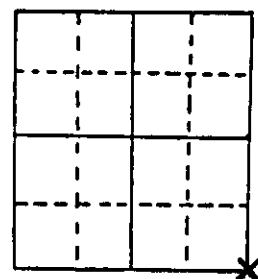

Section 31

(b) (f) (g) (h) Description of monument found at this corner and if it was accepted, state all evidence (material, testimonial, occupational, plats, records, other monuments) used as a basis for accepting. If not accepted or if nothing was found, state evidence used as basis for establishing location. If reestablished through lost corner proportionate methods, indicate all monuments, distances and directions used to establish.

September 3, 1860, Alfred Millard, set post for section corner.

- Original BTs = 8" Aspen, N24°E, 45 links (29.70').
- = 6" Aspen, S52°E, 23 links (15.18').
- = 6" Aspen, N42°W, 21 links (13.86').
- = 9" Aspen, N23°W, 37 links (24.42').

November 19, 1987, Milo E. Stefan found:

1. 1 1/2" iron pipe in mound of stone.
- *2. 12" White Pine stump with BT face, scribing burnt out, N40°E 26.20'
- *3. 24" White Pine with scribing 6"-8" deep in BT face, N24°W 32.82'
- **4. 4" Red Maple, N22°E, 29.47'.
- **5. 6" Red Maple, S22°E, 12.19')PK nail in BT face & scribed "BT"
- **6. 6" White Pine, S62°W, 14.45'


*These BT's scribed 60-80 years ago. *** New BT's 2 - 3 years ago.

I accept this position as the perpetuated section corner.

(c) (d) (e) Plan view of corner with ties to at least 4 witness monuments. If in disagreement with previously established corner, show the distances between the two corners and also indicate the ties to the disputed corner.

1. 2" x 30" Oneida County monument 24" in ground with mound of stone & earth around. Drove I.P. along side.
2. 4" Red Maple, N22°E, 29.47'.
3. 6" Red Maple, S22°E, 12.19'.
4. 6" White Pine, S62°W, 14.45'.
5. 24" White Pine, N24°W, 32.82'.
6. 12" White Pine stump, N40°E, 26.20'.
7. White plastic sign post, West, 1.8'.

Distances measured to nail in side of BT's.

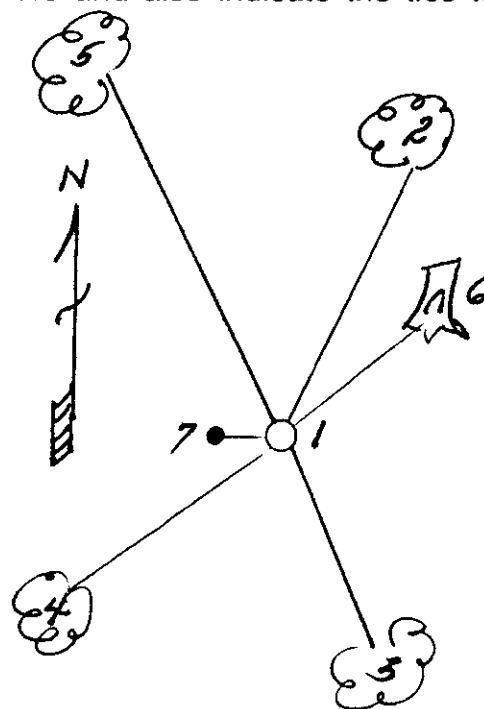

(i) I, Milo E. Stefan
 (type or print name) certify that the corner location on this record was determined by me or under my direction and control and that this U.S. Public Land Survey Monument Record is correct and complete to the best of my knowledge and belief.

Milo E. Stefan
 Signature

11/30/87
 Date



Index No. 2-5

3708310000