U.S. PUBLIC LAND SURVEY MONUMENT RECORD

Note: This form is intended and designed to fulfill all requirements of Wisconsin Administrative Code, Chapter A-E 5.02, U. Public Land Survey Monument Record (3) (a) (b) (c) (d) (e) (f) (g) (h) (i). An additional sheet may be added if necessary conform with said requirements.

(a) Corner location: Township 37 North

Range 8 East/~~West~~

Town/~~City/Village~~ Newbold

County Oneida

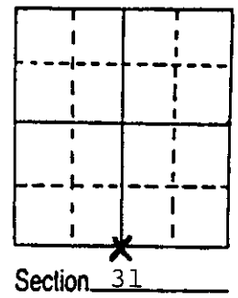

Section 31

(b) (f) (g) (h) Description of monument found at this corner and if it was accepted, state all evidenc (material, testimonial, occupational, plats, records, other monuments) used as a basis for accepting. not accepted or if nothing was found, state evidence used as basis for establishing location. reestablished through lost corner proportionate methods, indicate all monuments, distances an directions used to establish.

September 3, 1860, Alfred Millard, set post for 1/4 corner
Original BTs = 24" Red Pine, N42°E, 13 links (8.58').
= 9" Aspen, S24°E, 34 links (22.44').
November 19, 1987, Milo E. Stefan found:
1. 1 1/4" x 48" iron pipe in mound of stone with wood post along side
2. Original Red Pine, a badly decayed stump, N42°E, 8.6'.
3. 7" Red Oak, N21°E, 18.48')
4. 12" Red Oak, S30°E, 34.56')BT face with PK nails & scribed "BT".
5. 6" Red Oak, S62°W, 5.06')
I accept this position as the original 1/4 corner.

(c) (d) (e) Plan view of corner with ties to at least 4 witness monuments. If in disagreement with previously established corner, show the distances between the two corners and also indicate the ties to the disputed corner.

1. 2" x 30' Oneida County aluminum monument 24" in ground in mound of stone & earth. Iron pipe removed, post placed on top of mound.
2. 7" Red Oak, N21°E, 18.48'.
3. 12" Red Oak, S30°E, 34.56'.
4. 6" Red Oak, S62°W, 5.06'.
5. 13" Red Oak, N41°W, 19.23'. Scribed "T37N, R8E, S31, BT"
6. Stump of original Red Pine BT, N42°E, 8.58'.
7. White plastic sign post, East, 1.25'.

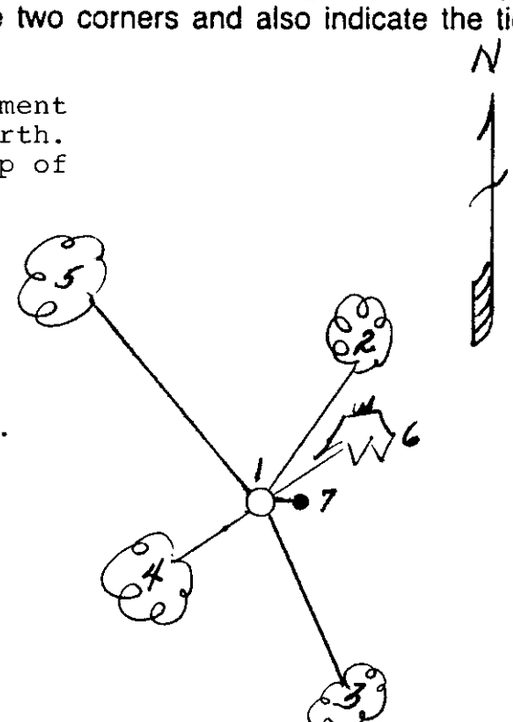

(i) I, Milo E. Stefan
(type or print name) certify that the corner location on this record was determined by me or under my direction and control and that this U.S. Public Land Survey Monument Record is correct and complete to the best of my knowledge and belief.

Milo E Stefan 11/30/87

Signature Date

WISCONSIN MILO E. STEFAN S 1558 RHINELANDER, WIS. LAND SURVEYOR

Index No. Z-3

3708310070