U.S. PUBLIC LAND SURVEY MONUMENT RECORD

Note: This form is intended and designed to fulfill all requirements of Wisconsin Administrative Code, Chapter A-E 7.08 U.S. Public Land Survey Monument Record (3) (a) (b) (c) (d) (e) (f) (g) (h) (i). An additional sheet may be added if necessary to conform with said requirements.

(a) Corner location: Township 37 North

Range 8 East/[redacted]

Town/City/Village Newbold

County Oneida

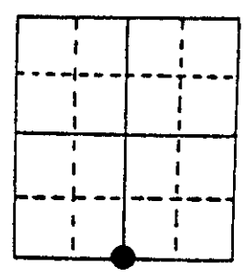

Section 33

(b) (f) (g) (h) Description of monument found at this corner and if it was accepted, state all evidence (material, testimonial, occupational, plats, records, other monuments) used as a basis for accepting. If not accepted or if nothing was found, state evidence used as basis for establishing location. If reestablished through lost corner proportionate methods, indicate all monuments, distances and directions used to establish. Indicate type of monument found or set and sign post.

-1860 Millard set ¼ Post Aspen 7" N 43 W 7 lks. Aspen 7" S 85 E 16 lks.
-1899 Vaughan found ¼ Post in center between corners.
-1928 G.L.O. found wood stake and set 2" capped iron pipe. Local BT's Pine stump 8" N 65 W 3 lks. Pine stump 14" S 15 E 48 lks. W. Pine 12" N 8-15 W 129 lks.
-1930 Hall at corner.
-1963 Resvick at corner.
-1968 Wisconsin D.O.T. references wrong corner.
-1989 W.E. Bandow set Oneida County Monument and made references as shown below.
White plastic Post N 7 E 16.5'.

(c) (d) (e) Plan view of corner with ties to at least 4 witness monuments. If in disagreement with previously established corner, show the distances between the two corners and also indicate the ties to the disputed corner.

NOTE:
MEASUREMENTS TAKEN FROM 6" SPIKE IN SIDE OF TREES

BEARINGS TAKEN WITH HANDHELD MAGNETIC COMPASS

NO SCALE

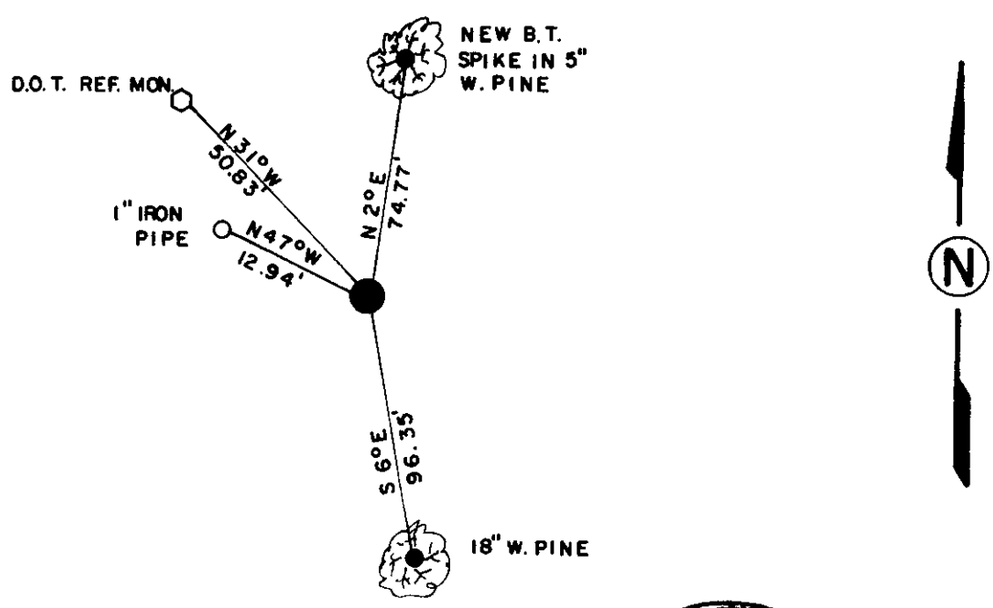

(i) I, William E. Bandow (type or print name) certify that the corner location on this record was determined by me or under my direction and control and that this U.S. Public Land Survey Monument Record is correct and complete to the best of my knowledge and belief.

William E. Bandow 12-27-89

Signature Date

WISCONSIN WILLIAM E. BANDOW S-1182 RHINELANDER WIS. LAND SURVEYOR

Index No. 7-11

3708 330020