U.S. PUBLIC LAND SURVEY MONUMENT RECORD

Note: This form is intended and designed to fulfill all requirements of Wisconsin Administrative Code, Chapter A-E 7.08 U.S. Public Land Survey Monument Record (3) (a) (b) (c) (d) (e) (f) (g) (h) (i). An additional sheet may be added if necessary to conform with said requirements.

(a) Corner location: Township 37 North

Range 8 East/~~West~~

Town/~~City/Village~~ Newbold

County Oneida

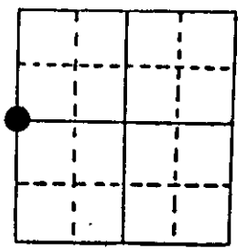

Section 34

(b) (f) (g) (h) Description of monument found at this corner and if it was accepted, state all evidence (material, testimonial, occupational, plats, records, other monuments) used as a basis for accepting. If not accepted or if nothing was found, state evidence used as basis for establishing location. If re-established through lost corner proportionate methods, indicate all monuments, distances and directions used to establish. Indicate type of monument found or set and sign post.

1863 - Wm. Daugherty established corner and set a wood post:
15" Red Pine, N31°E, 26 links (17.16') 15" Red Pine, S38°W, 9 links (5.94')

1927 - GLO restored corner from remains of original BTs and set a brass cap and iron post GLO monument with new BTs:
12" White Birch, N23°E, 11.5' 10" White Birch, N53°W, 11.5'

4/4/89 - Found GLO Monument and both birch BTs in good condition. Remains of original Red Pine stump still here. We made two new BTs as follows:
3" Red Oak, N12°W, 32.30' 12" Red Pine, S15°W, 73.97'
Placed plastic sign post, NW, 2.0'

(c) (d) (e) Plan view of corner with ties to at least 4 witness monuments. If in disagreement with previously established corner, show the distances between the two corners and also indicate the ties to the disputed corner.

1. GLO brass cap on 1 1/2" iron pipe
2. 12" White Birch, N23°E, 11.5' (1927 GLO)
3. 12" Red Pine, S15°W, 73.97'
4. 10" White Birch, N53°W, 11.5' (1927 GLO)
5. 3" Red Oak, N12°W, 32.30'
6. Plastic sign post, NW, 2.0'

Distances to nail in side of tree.
"BT" scribed in stump blaze.

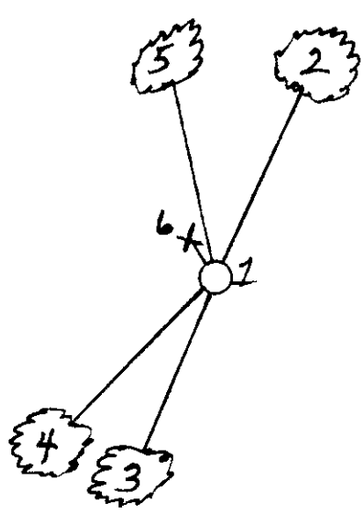

(i) I, Milo E. Stefan (type or print name) certify that the corner location on this record was determined by me or under my direction and control and that this U.S. Public Land Survey Monument Record is correct and complete to the best of my knowledge and belief.

Milo E. Stefan April 18, 1989

Signature Date

WISCONSIN MILO E. STEFAN S-1558 RHINELANDER, WIS. LAND SURVEYOR

Index No. X-13

370833 2000