U.S. PUBLIC LAND SURVEY MONUMENT RECORD

Note: This form is intended and designed to fulfill all requirements of Wisconsin Administrative Code, Chapter A-E 5.02, U.S. Public Land Survey Monument Record (3) (a) (b) (c) (d) (e) (f) (g) (h) (i). An additional sheet may be added if necessary to conform with said requirements.

(a) Corner location: Township 37 North

Range 8 East/

Town/City/Village Newbold

County Oneida

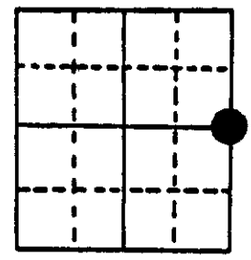

Section 34

(b) (f) (g) (h) Description of monument found at this corner and if it was accepted, state all evidence (material, testimonial, occupational, plats, records, other monuments) used as a basis for accepting. If not accepted or if nothing was found, state evidence used as basis for establishing location. If reestablished through lost corner proportionate methods, indicate all monuments, distances and directions used to establish.

-1863 W.E. Daugherty 40 ch. set 1/4 Post (Tam 8" N 76 W 15 lks, Tam 8" S 54 E 10 lks).
-1908 Vaughan went to E 1/4 found stumps of original B.T.s set Post.
-1911 Vaughan stumps of B.T.s ok.
-1978 George Drivas found corner.
-1979 William Immich was at corner found iron bar.
-1988 William E. Bandow found iron bar and wood Post no sign of B.T.s. Set 1/2" Re-bar between wood Post and iron bar. Re-bar is capped with 2" aluminum cap stamped to identify corner white plastic sign post, E, 1 foot corner referenced as shown below.

(c) (d) (e) Plan view of corner with ties to at least 4 witness monuments. If in disagreement with previously established corner, show the distances between the two corners and also indicate the ties to the disputed corner.

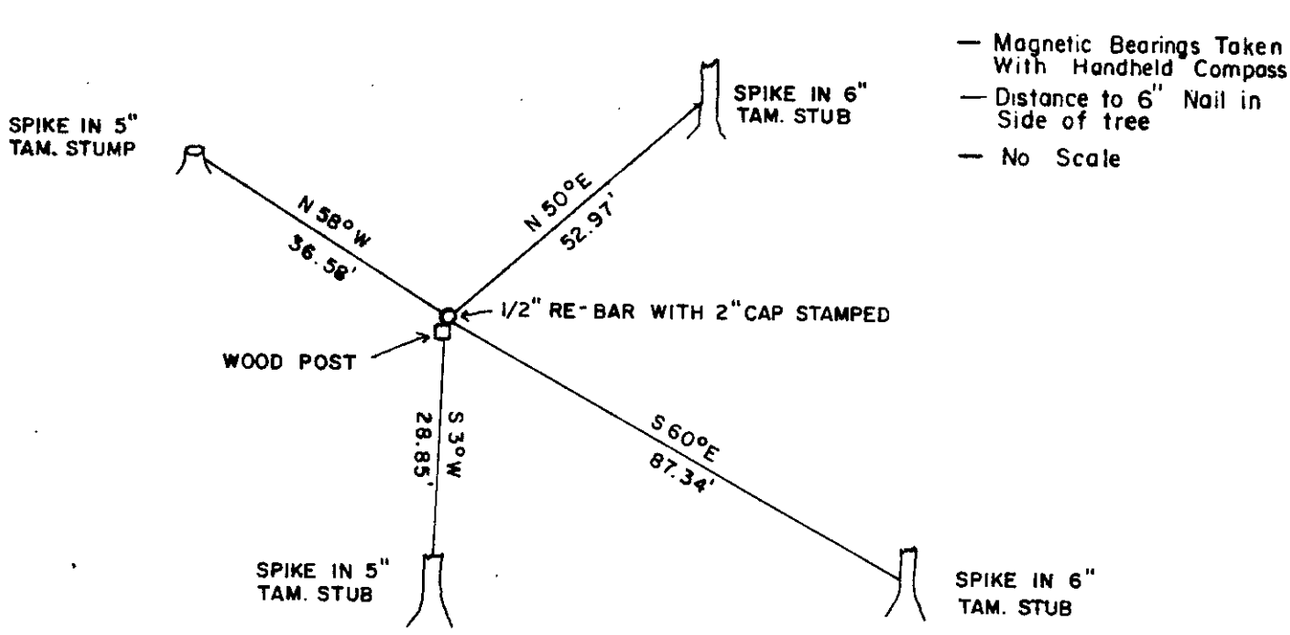

(i) I, William E. Bandow (type or print name) certify that the corner location on this record was determined by me or under my direction and control and that this U.S. Public Land Survey Monument Record is correct and complete to the best of my knowledge and belief.

William E. Bandow 12-5-88

Signature Date

GENISOT & ASSOCIATES INC.
1512 EAGLE ST., RHINELANDER, WIS.

WISCONSIN WILLIAM E. BANDOW S-1182 RHINELANDER WIS. LAND SURVEYOR

Index No. X-17

37CS242000