

# U.S. PUBLIC LAND SURVEY MONUMENT RECORD

Note: This form is intended and designed to fulfill all requirements of Wisconsin Administrative Code, Chapter A-E 7.08 U.S. Public Land Survey Monument Record (3) (a) (b) (c) (d) (e) (f) (g) (h) (i). An additional sheet may be added if necessary to conform with said requirements.


(a) Corner location: Township 37 North

Range 8 East/West

Town/City/Village Pine Lake

County Oneida

REGISTER OF DEEDS OFFICE  
ONEIDA COUNTY, WIS.  
**FILED**  
MAY 30 1991  
At \_\_\_\_\_ O'Clock \_\_\_\_\_ M  
**THOMAS H. LEIGHTON**  
REGISTER OF DEEDS

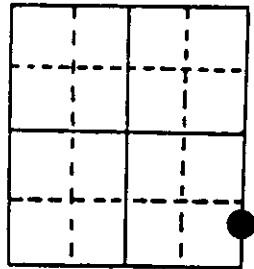

Section 36

(b) (f) (g) (h) Description of monument found at this corner and if it was accepted, state all evidence (material, testimonial, occupational, plats, records, other monuments) used as a basis for accepting. If not accepted or if nothing was found, state evidence used as basis for establishing location. If reestablished through lost corner proportionate methods, indicate all monuments, distances and directions used to establish. Indicate type of monument found or set and sign post.


Sept. 1860 - H. C. Fellows established this corner at 12.00 chains north of the Township Corner, set a wood post with BTs:  
7" Willow, N10°W, 12 Links                      7" Elm, S38°E, 13 Links

2/14/1991 - Milo E. Stefan in survey of range line from Quarter Corner northerly to Township Corner southerly, finds the Meander Corner by Fellows now falls in the flowage created by the dam on the Wisconsin River, now known as Boom Lake. We, therefore, established a Witness Corner Meander Corner on the south shore of Boom Lake that witnesses the proportioned position of the original Meander Corner. See drawing on back of this sheet.

(c) (d) (e) Plan view of corner with ties to at least 4 witness monuments. If in disagreement with previously established corner, show the distances between the two corners and also indicate the ties to the disputed corner.

- 1) 2" x 36" Aluminum county monument
- 2) 3" White Birch, N45°E, 22.04 feet
- 3) 6" White Birch, N78°W, 32.76 feet
- 4) 1 1/2" Iron Pipe, South, 286.50 feet
- 5) Plastic sign post, South, 1.3'
- 6) 10" White Birch, N27°W, 10.77'

Distance to nail in side of BT.  
Stump blaze scribed, "BT".

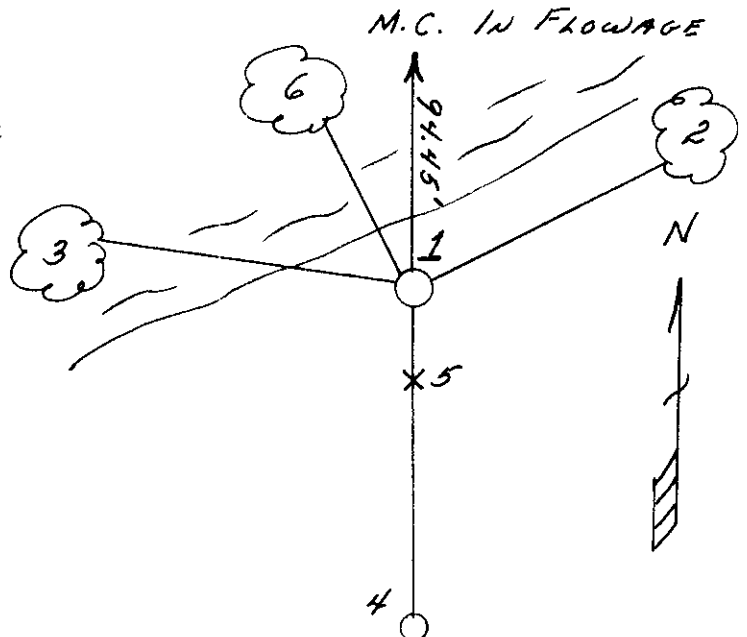



(i) I, Milo E. Stefan  
(type or print name) certify that the corner location on this record was determined by me or under my direction and control and that this U.S. Public Land Survey Monument Record is correct and complete to the best of my knowledge and belief.

Milo E. Stefan  
Signature

April 18, 1991  
Date



Stamp  
3708 31-01-00

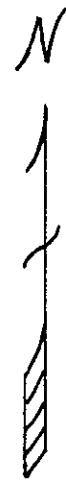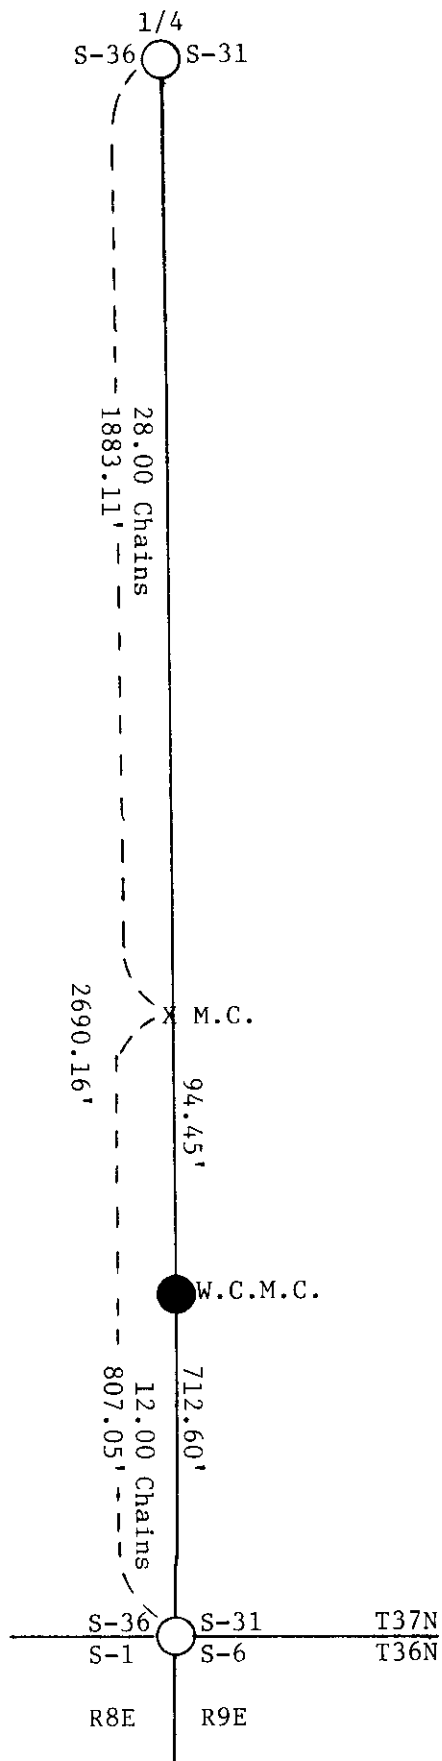

GLO distances in chains  
Recent measure in feet