


# U.S. PUBLIC LAND SURVEY MONUMENT RECORD

**Note:** This form is intended and designed to fulfill all requirements of Wisconsin Administrative Code, Chapter A-E 7.08 U.S. Public Land Survey Monument Record (3) (a) (b) (c) (d) (e) (f) (g) (h) (i). An additional sheet may be added if necessary to conform with said requirements.

(a) Corner location: Township 37 North  
 Range 8 East/West  
 Town/City/Village Pine Lake  
 County Oneida

REGISTER OF DEEDS OFFICE  
 ONEIDA COUNTY, WIS.  
**FILED**  
 MAY 30 1991  
 AT \_\_\_\_\_ O'Clock \_\_\_\_\_ M  
**THOMAS H. LEIGHTON**  
 REGISTER OF DEEDS

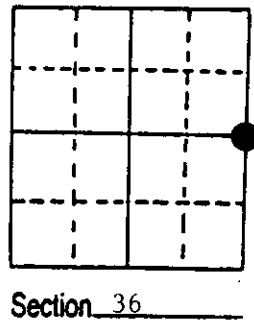


(b) (f) (g) (h) Description of monument found at this corner and if it was accepted, state all evidence (material, testimonial, occupational, plats, records, other monuments) used as a basis for accepting. If not accepted or if nothing was found, state evidence used as basis for establishing location. If reestablished through lost corner proportionate methods, indicate all monuments, distances and directions used to establish. Indicate type of monument found or set and sign post.

- Sept. 1860 - H.C. Fellows established this corner at 40.00 chains and set a wood post with two BTs:  
 15" Red Pine, S82°E, 35 Links                      15" White Pine, N65°W, 11 Links
- 7/17/1913 - Vaughan was at corner and found Northwest BT standing. He was working in Section 31 and measured the Range Line Southerly to Township Corner to be 40.57 chains. We find it to be 40.76 chains.
- 5/17/1922 - J.E. Hill, in the preparation of the Shady Point Plat, used this corner and he set Lot Corner, North, 15'.
- 6/28/1968 - Sye Poskie used this corner to run the East - West Quarter Line to Section 36.
- 1/15/1979 - John Fisher notes in county surveyor's office calls for a 1 1/2" iron pipe on North edge of blacktop of Trails End Road to be the Quarter Corner.
- 2/13/1991 - Milo E. Stefan located the 1 1/2" iron pipe and measured Range Line Southerly to Township Corner. I accept this iron pipe as the perpetuated original corner and restore same as indicated below.

(c) (d) (e) Plan view of corner with ties to at least 4 witness monuments. If in disagreement with previously established corner, show the distances between the two corners and also indicate the ties to the disputed corner.

- 1) 2" x 36" aluminum monument, 6" below road shoulder surface
- 2) 16" White Pine, N4°E, 29.53 feet
- 3) 12" Red Oak, N25°E, 38.70 feet
- 4) 14" Red Pine, S8°E, 63.73 feet\*
- 5) 7" Red Oak, S20°W, 59.12 feet\*
- 6) 1 1/4" x 12" galv. iron pipe, North, 14.91 feet with 3/4" x 3/4" square iron rod inside (Lot Corner). "SW Corner Lot 1, Block 1, Shady Point Plat".
- 7) Plastic sign post, North, 17.0 feet

\*Stump blazed "BT".  
 Distances to nail in side of tree.

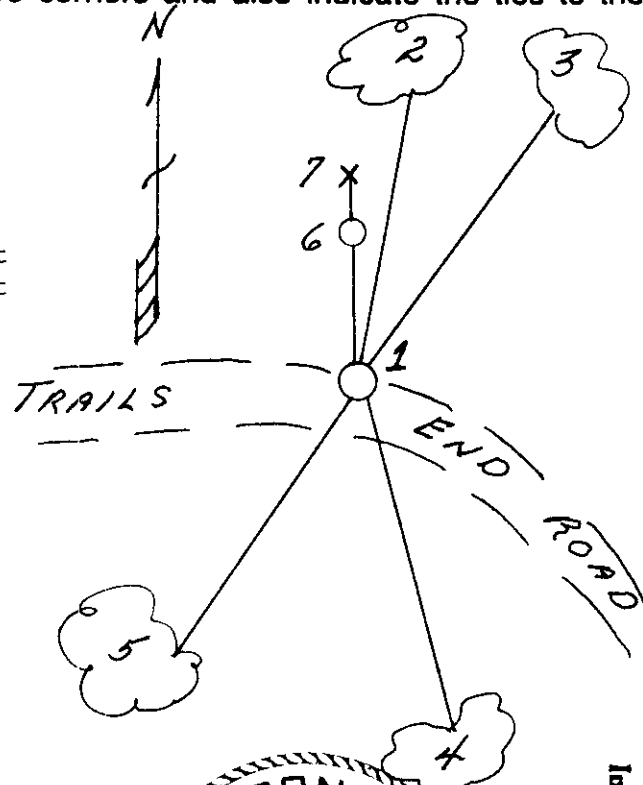

(i) I, Milo E. Stefan  
 (type or print name) certify that the corner location on this record was determined by me or under my direction and control and that this U.S. Public Land Survey Monument Record is correct and complete to the best of my knowledge and belief.

Milo E. Stefan  
 Signature

April 18, 1991  
 Date



Index No. X-25

Stamp  
 3708362000