

CERTIFIED LAND CORNER RESTORATION

Index No. **E-23**

State of Wisconsin

County of Oneida } ss.


I, Philip J. Hansen, do hereby certify that on the 27th day of September, 1976, I found evidence of the corner of section 1, T. 27 N., R. 27 E., Township 27 North, Range 27 East, Fourth Principal Meridian, as described hereon; and that from this evidence I established a new monument and accessories as described hereon to perpetuate the original location of this corner.

Resident witnesses:

Jim Martin

Herb Wagner

T37E R27E

 

History of original corner establishment:


Original corner established by J. J. Johnson, Register, in 1869, in which corner was set in 1869 - 12.11 links and also 10th corner 2.45 links. Corner re-established by J. J. Johnson, Surveyor, set iron pipe with cross cap. marked with black spruce 50 x 823 = 10.4 links. Black spruce 70 x 450 = 17.0 links.

Description of corner evidence found:

Recovered 4 1/2" iron pipe with 4" square brass cap. Recovered 2 1/2" iron pipe with 3 1/2" x 3 1/2" x 10.4 links, setting not visible. 1/4 x 1/4 x 12 Black spruce 70 x 450 = 17.0 links, set in 1/4 sec. IR.

Description of monument and accessories I established to perpetuate the original location of this corner.

As monument was recovered in poor condition and 1 1/2" in ground, it was left in place. Monument projects 4 1/2" above ground. 101 - Black spruce 50 x 823 = 10.4 links, set in 1/4 sec. IR.

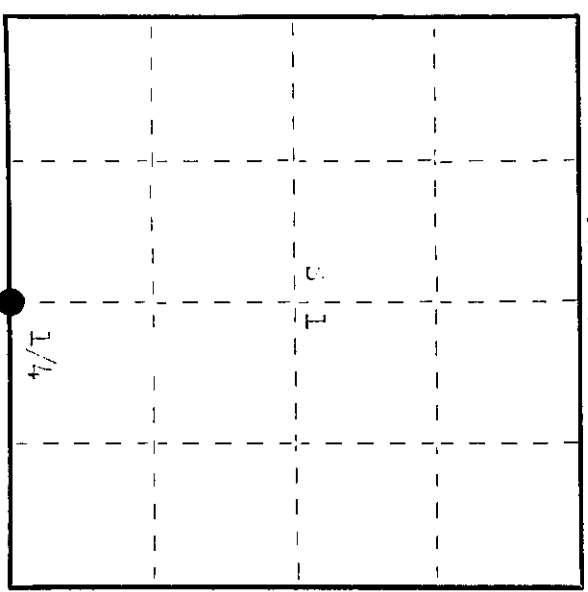

○ = Corner monument restored.

Dated at Oneida, Wis., this 27th day of September, 1976.

Signature: *Philip J. Hansen* Title: Registered Land Surveyor, or other duly authorized official Registration No. 438

Office of Register of Deeds, County of Oneida. I hereby certify that the within instrument was filed in this office for record on the 2nd day of December, 1976, at 9:30 o'clock P.M.

Deane Terage Fischer (Register of Deeds)

By: Deputy

3709010020