
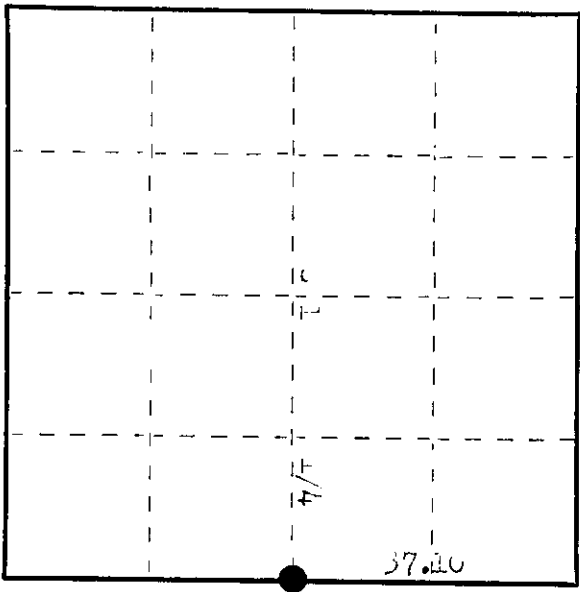


State of Wisconsin }

I, Philip J. Stammers, do hereby certify that on the 24th day of September, 1975, I found evidence of the barber corner of section 1 & 6 Township 27, North, Range 14, East, Fourth Principal Meridian, as described hereon; and that from this evidence I established a new monument and accessories as described hereon to perpetuate the original location of this corner.

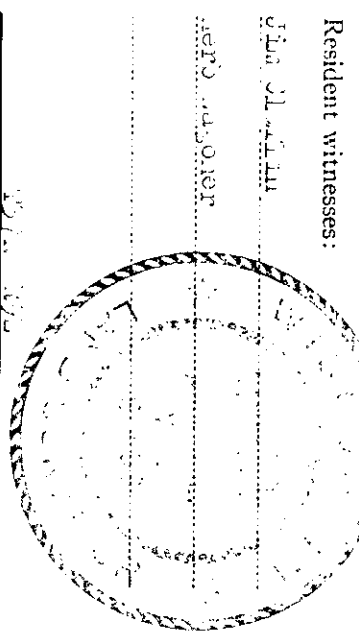

○ = Corner monument restored.

CERTIFIED LAND CORNER RESTORATION

Index No. C-25

History of original corner establishment:

original corner established by Wm. J. Fellows, John W. Carver, in 1860.
corner recovered by Wm. J. Carver, in 1894.
corner recovered by H. Loftus, Algeo Carver, in 1950. set 2 1/2" iron pipe with 4" square brass cap.

Description of corner evidence found:

recovered 2 1/2" iron pipe with 4" square brass cap, set 1/4" from monument recovered in good condition.
also recovered old 3" square old post, set 1/4" - 1/4" from monument, but could possibly be J.H. Langford's post, and recovered same monument, but made no reference to post or pipe in notes.
recovered 1 1/2" x 1 1/2" x 1 1/2" brass, set 1/4" from monument.
no record of any other brass caps.



Description of monument and accessories I established to perpetuate the original location of this corner.

as the monument was recovered in good condition, and found in place, monument posts and other accessories were not replaced.

Dated at Waushara, Wis., this 24th day of September, 1975.

Signature Philip J. Stammers Title Registered Land Surveyor Registration No. 7470
(County Surveyor, Registered Land Surveyor, or other duly authorized official)
Office of Register of Deeds, County of Waushara, Wis.
Instrument was filed in this office for record on the 24th day of September, 1975 at 9:30 o'clock P.M.

By Bona Verage Tucker (Register of Deeds)

By _____ Deputy

3709012000