

CERTIFIED LAND CORNER RESTORATION

Index No. **C-23**

State of Wisconsin




I, Philip G. Hansen, do hereby certify that on the 19th day of November, 1979, I found evidence of the 0 1/4 corner of Section 1, Township 27, North, Range 2 East, Fourth Principal Meridian, as described hereon; and that from this evidence I established a new monument and accessories as described hereon to perpetuate the original location of this corner.

Resident witnesses:

Jim J. ...

...

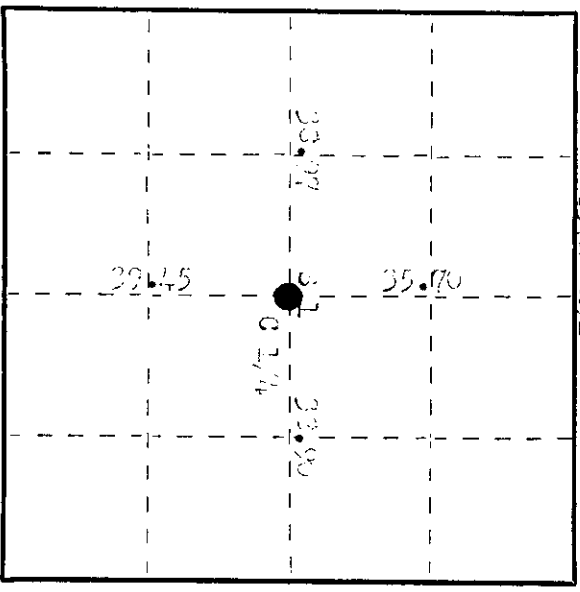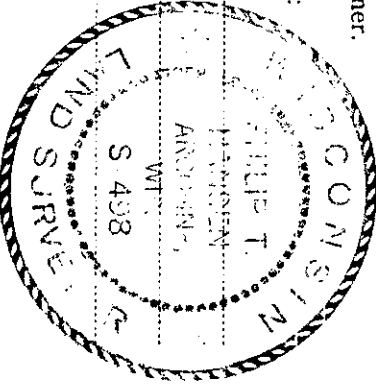

History of original corner establishment:

Corner was blished by ... 30 301 ... 30 131 ... of 1/4, corrected line and established 1/4 corner.

Description of corner evidence found:

recovered 3" iron pipe with 4" x 4" square brass cap in good condition and secured in ground. recovered 3" iron pipe (9") ... 30 131 ... monument projects 30' above ...

Description of monument and accessories I established to perpetuate the original location of this corner.

as the monument was recovered in 1900 ... all accessories attached to center of brass.

Dated at Milwaukee, Wis., this 19th day of November, 1979.



Doris Verage Kuehn (Register of Deeds)

By: ... Deputy

3709012020

○ = Corner monument restored.