

CERTIFIED LAND CORNER RESTORATION

Index No. **C-22**

State of Wisconsin

County of **Oneida** } ss.

I, **Phillip W. Hansen**, do hereby certify that on the **16th** day of **December**, 19 **76**, I found evidence of the **WC 1/16**

corner of **Section 1** Township **37** North, Range

9 East, Fourth Principal Meridian,

as described hereon; and that from this evidence I established a new monument and accessories as described hereon to perpetuate the original location of this corner.

Resident witnesses:

Jim Clarin

Herb Wagoner

History of original corner establishment:

Corner established by N. Loftus, Ripco Surveyor, in 1956. Ran random line N 87° E from a point 35 links North of the W 1/4 corner 76.89 chains to close out 1.61 chains North of the E 1/4 corner. Established C 1/4 corner at 38.95 chains and the WC 1/16 at 19.47 1/2 chains intermediate between C 1/4 corner and W 1/4. Marked NBTs - Jack Pine 12" N 54° E 99 links and Jack Pine 11" S 60° W 97 1/2 links.

Description of corner evidence found:

Recovered 1" OD iron pipe with 2" brass cap stamped:

Monument recovered in good condition and securely in ground.

Recovered OBTs - Jack Pine 12" (18") N 54° E (N 59° E) 99.0 links.

Jack Pine 11" (18") S 60° W (S 69° W) 97.5 links.

Both BTs scribed 1/16 BT.


T37N R9E
W 1/16
S 1
RIPCO

Description of monument and accessories I established to perpetuate the original location of this corner.

As monument was recovered in good condition, it was left in place.

Monument projects 10" above ground.

Placed a location tag on N-S logging road, 15 chains west of corner.

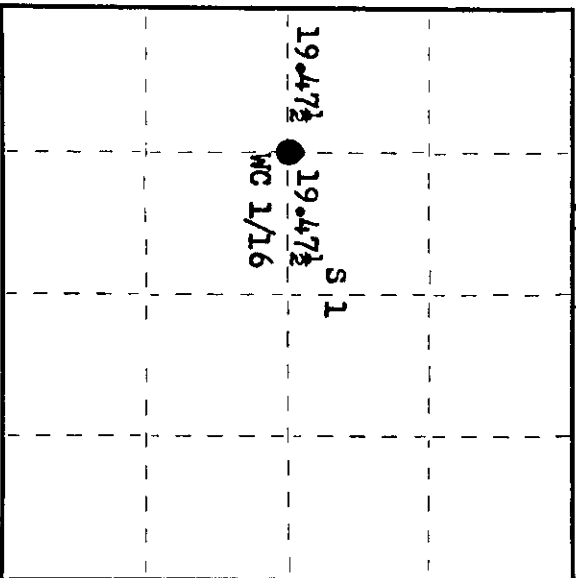

○ = Corner monument restored.

Dated at **Rhinelander**, Wis., this **22nd** day of **December**, 19 **76**

Signature **Phillip W. Hansen** Title **Registered Land Surveyor** Registration No. **S-4-98**
(County Surveyor, Registered Land Surveyor, or other duly authorized official)

Office of Register of Deeds, County of **Oneida** at **10:00** o'clock **AM**, 19 **77** day of **February**

Estelle Thayer Huske
(Register of Deeds)

By **Joseph H. ...** Deputy

3709012030