

CERTIFIED LAND CORNER RESTORATION



Index No. **B-25**

State of Wisconsin } ss.
County of Waushara

I, Phillip D. Stemann, do hereby certify that on the 17th day of October, 1970, I found evidence of the 1/16 corner of Section 1, T. 27 N., R. 10 E., S. 1 W., Waushara County, Wisconsin, North, Range 10, Township 27, Fourth Principal Meridian, as described hereon; and that from this evidence I established a new monument and accessories as described hereon to perpetuate the original location of this corner.

Resident witnesses:

Jim Stettin

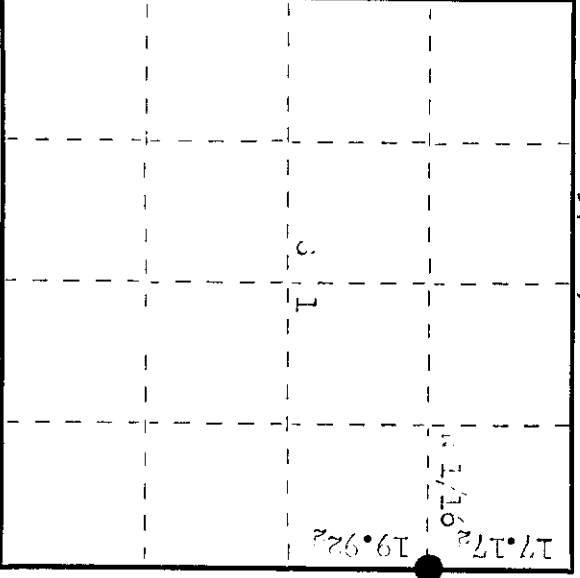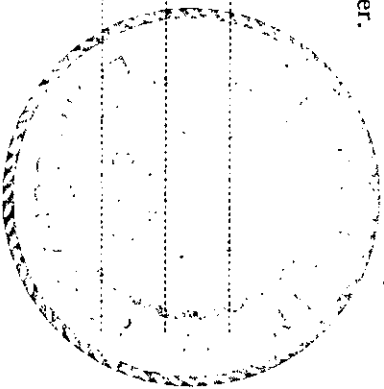


History of original corner establishment:



Description of corner evidence found:


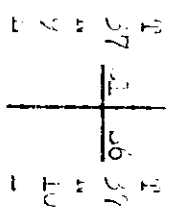

Description of monument and accessories I established to perpetuate the original location of this corner.

As monument was recovered in good condition, and being in place, it was left in place. Monument projects 6" above ground. Set a 6 lb. nickel steel monument. 27 - Block of pine 2" x 6" x 72" long, scribbled 1/16.

Dated at Amiel under Wis., this 27th day of October, 1970.

Signature Phillip D. Stemann Title Registered Land Surveyor Registration No. 7478
(County Surveyor, Registered Land Surveyor, or other duly authorized official)

Office of Register of Deeds, County of Waushara. I hereby certify that the within instrument was filed in this office for record on the 27th day of December, 1970 at 9:30 o'clock A.M.

David Terence Fuchler
(Register of Deeds)

By: _____ Deputy

3709013000