

CERTIFIED LAND CORNER RESTORATION

Index No. **B-23**

State of Wisconsin

County of **Oneida**

ss.

I **Phillip T. Hansen**, do hereby certify that on the **3rd** day of **December**, 19**76**, I found evidence of the **NC 1/16** corner of **Section 1**



Township **37**, North, Range **9 East**, Fourth Principal Meridian,

as described hereon; and that from this evidence I established a new monument and accessories as described hereon to perpetuate the original location of this corner.

Resident witnesses:

**Jim Clafflin**

**Herb Wagoner**

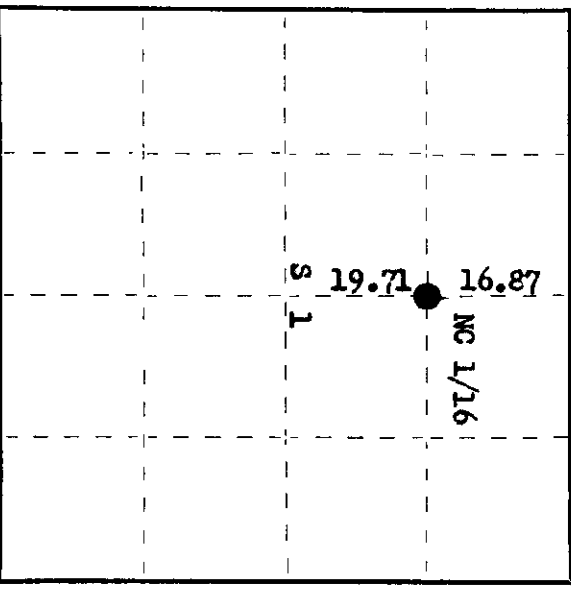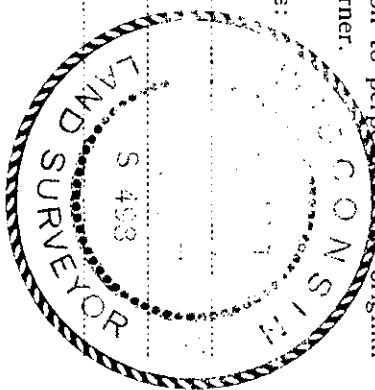

O = Corner monument restored.

History of original corner establishment:

Corner established by N. Loftus, Ripco Surveyor, in 1956. Ran random line for N-S 1/4 line 50' 10' W from N 1/4 corner to close out 1.55 chains west of S 1/4 corner. Set NC 1/16 corner at 16.87 chains on true bearing S 1° E from which Tamarack 8" bears S 3° W 76 links, Tamarack 5" bears S 63° W 99 links.

Description of corner evidence found:

Recovered 1" iron pipe with 2" square brass cap stamped:  
 Monument projects 12" above ground. T37N R9E  
 Recovered OBT - Tamarack 8" S 30° W 76 links (our bearing S 10° W), C  
 Scribed 1/16 BT (now dead). N 1/16 + S 1  
 Tamarack 5" S 63° W (S 70° W) 99 links, scribed C  
 CN 1/16 BT (dead). R1P00

Description of monument and accessories I established to perpetuate the original location of this corner.

As monument was in good condition and securely in ground, it was left in place.

Marked NBRTs - Red Pine 8" S 1° E 119.2 links, scribed 1/16 BT.  
 Red Pine 8" S 61° W 141.3 links, scribed 1/16 BT.

All distances measured to center of tree.  
 Corner sets 2 chains north of E-W logging road.

Dated at **Rhineclander**, Wis., this **22nd** day of **December**, 19**76**

Signature *Phillip T. Hansen* Title **Registered Land Surveyor** Registration No. **S-498**  
 (County Surveyor, Registered Land Surveyor, or other duly authorized official)

Office of Register of Deeds, County of **Oneida**, I hereby certify that the within instrument was filed in this office for record on the **13th** day of **February**, 19**77** at **10:22** o'clock **A**. M.

*James George Tushnet*  
 (Register of Deeds)

By *Joseph M. Brown* Deputy

3709013020