CERTIFIED LAND CORNER RESTORATION

Index No. D-19

State of Wisconsin
County of Oneida } ss.

I Philip T. Hansen, do hereby certify that on the 4th day of October, 19 70, I found evidence of the SC 1/16 corner of Section 2 Township 37, North, Range 9 East, Fourth Principal Meridian, as described hereon; and that from this evidence I established a new monument and accessories as described hereon to perpetuate the original location of this corner.

Resident witnesses:

Jim Slaflin

Herb Wagoner

WISCONSIN PHILIP T. HANSEN S-498 LAND SURVEYOR

History of original corner establishment:

Corner established by R. Loftus, Rice Surveyor, in 1956. Ran random line N 3° 30' W from S 1/4 corner 75.15 chains to close out 58 links west of N 1/4 corner.
True bearing N 3° 15' W.
Set SC 1/16 corner at 19.72 chains, equidistant between S 1/4 and C 1/4.
Marked Tamarack 7" S 3° E 1.25 chains.

Description of corner evidence found:

Recovered 1" OD iron pipe with 2" square brass cap stamped:
Monument recovered in good condition.
Recovered BT - Tamarack 7" (8") N 3° W 125.0 links, scribing not legible. S 1/16

Description of monument and accessories I established to perpetuate the original location of this corner.

As monument recovered in good condition and fir 1' in ground, it was left in place.
Dated October, 1970. Ran to brass cap.
Monument projects 20" above ground.
BT - Red Pine 6" N 60° E 16.4 links, scribed 1/16 SF.

T37N R9E

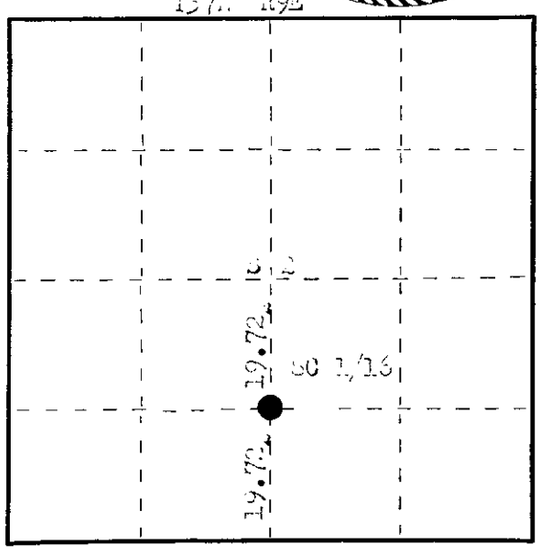

○ = Corner monument restored.

Dated at Rhinelander, Wis., this 5th day of November, 19 70

Signature Philip T. Hansen Title Registered Land Surveyor Registration No. S-498
(County Surveyor, Registered Land Surveyor, or other duly authorized official)

Office of Register of Deeds, County of Oneida, I hereby certify that the within instrument was filed in this office for record on the 2nd day of December, 19 76 at 9:30 o'clock A M.

Doris Veroge Kuehn
(Register of Deeds)

By ..... Deputy

FORM 985 H. C. MILLER CO., MILWAUKEE

370902 10 20