

CERTIFIED LAND CORNER RESTORATION

State of Wisconsin

County of Chanda

ss.

I, James D. Rein, do hereby certify that on the 13th day of November, 1977, I found evidence of the Chanda corner of Section 9 and 4 Township 37 north Range 2 east, Fourth Principal Meridian, as described hereon; and that from this evidence I established new monument and accessories as described hereon to perpetuate the original location of this corner:



Description of original monument and accessories and subsequent restorations:
 wood post set by William E. Laugherty, Deputy Surveyor, on September 1st, 1863, witnessed by a 12" birch bearing N6°W, 12 lks (7.92 feet) and by an 8" Birch bearing S23°E, 27 lks (17.82 feet),
 NIPCO survey monument set by Norman Loftus, Reg. Land Surveyor, using record survey information and extending through the 1/4 from the 3-1/4 of Section 9. Corner location intersects an old east-west plow furrow ridge.

Description of corner evidence found:
 recovered a 2" diameter I.P. with 4" x 4" square stamped plate (NIPCO) up 18" Corner is located plus or minus 40 feet north of the centerline of an existing road running in a general east-west direction and plus or minus 42 feet south-west of the centerline of another road which runs in a general southeast and northwest direction.

Description of monument and accessories I established to perpetuate the location of this corner:
 As monument was recovered in good condition and firmly in ground it was left in place.
 Made the following scribed bearing trees with I.K. nails set in lower blaze to witness corner location.

- 7" White Pine S50°E, 3.56 feet
- 12" Norway Pine S8°W, 11.24 feet
- 8" Norway Pine N63°W, 76.40 feet

These are copies of a copy
 Originals Apparently misplaced
 mqr 3/5/91

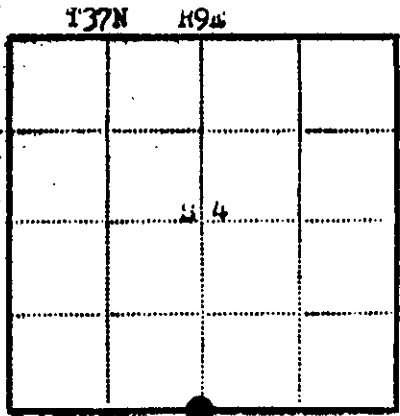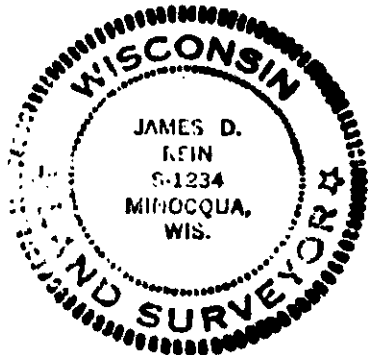

Resident witnesses none

Dated at Minocqua Wisconsin, this 13th day of November 1977.

Signature James D. Rein Title Reg. Land Surveyor
 (County Surveyor, Registered Land Surveyor, or other duly authorized official)

Surveyors Registration 10-1234

Office of _____ County of _____

I hereby certify that the within instrument was filed in this office for record on the _____ day of _____ 19____, and was filed in Book No. _____ Page No. _____ County Records.

Signature _____ Title _____

Township _____ Range _____ Section _____, Index No. _____, Page No. _____