

CERTIFIED LAND CORNER RESTORATION

Index No. H-16

State of Wisconsin

County of Oneida

} ss.

I Phillip T. Hansen, do hereby certify that on the 17th day of December, 1976, I found evidence of the SE 1/16 corner of Section 10



Township 37, North, Range 9 East, Fourth Principal Meridian,

as described hereon; and that from this evidence I established a new monument and accessories as described hereon to perpetuate the original location of this corner.

Resident witnesses:

Jim Clarlin

Herb Wagoner

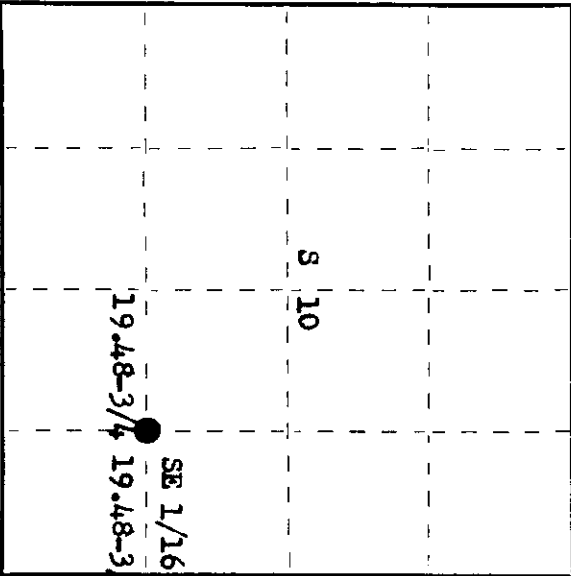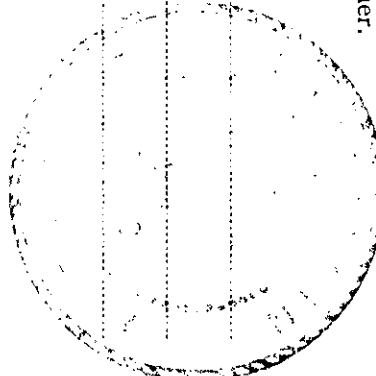

○ = Corner monument restored.

History of original corner establishment:

Corner established by N. Loftus, Ripco Surveyor, in 1958. From re-established EC 1/16 he ran 181° 30' mag. 38.90 chains to close out 1/4 links east of the E 1/16 corner. Set SE 1/16 corner at 7 1/2 links west intermediate at 19.45 chains. Marked NBTs - Red Maple 4" N 80° W 33 links and Red Maple 4" S 68° E 37-3/4 links.

Description of corner evidence found:

Recovered 1 1/4" iron pipe with 2" brass cap stamped:
Monument recovered in good condition and securely in ground.
Recovered OBTs - Maple 4" (6") N 89° W (N 2° E) 33.0 links.
Maple 4" (6") S 68° E 37.75 links, now dead, scribing not visible)
T37N R9E
SE 1/16 S10
RIPCO

Description of monument and accessories I established to perpetuate the original location of this corner.

As monument was recovered in good condition, it was left as found.
Monument projects 30" above ground.
NBT - Maple 7" S 72° E 39.2 links, scribed 1/16 BT.

Dated at Rhinelander, Wis., this 22nd day of December, 1976.

Signature Phillip T. Hansen Title Registered Land Surveyor Registration No. S-498
(County Surveyor, Registered Land Surveyor, or other duly authorized official)

Office of Register of Deeds, County of Oneida
Instrument was filed in this office for record on the 10th day of February, 1977 at 10:00 o'clock A. M.

Lena Wraga Kuehn
(Register of Deeds)

By Joseph M. Wagoner Deputy

3709101010