

CERTIFIED LAND CORNER RESTORATION

Index No. **L-5**

State of Wisconsin



County of Oneida } ss.

I, Philip W. Hansen, do hereby certify that on the 24th day of August, 1976, I found evidence of the starter corner of section 17 and 18 Township 37 North, Range 9 East, Fourth Principal Meridian, as described hereon; and that from this evidence I established a new monument and accessories as described hereon to perpetuate the original location of this corner.

Resident witnesses:

Jim Clafflin

Herb Wagner

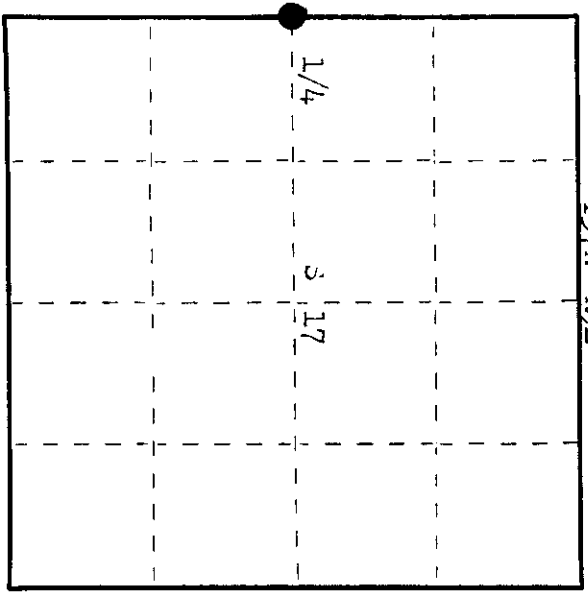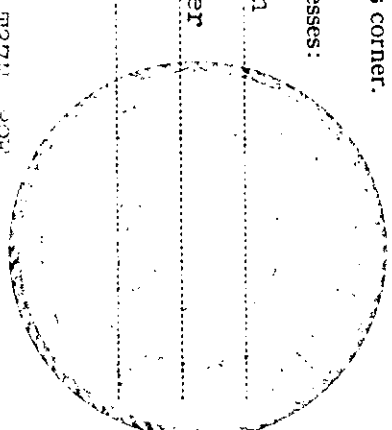

○ = Corner monument restored.

History of original corner establishment: Original corner established by Wm. J. Dougherty, Deputy Surveyor, in 1863, from which seven 10" bears 120° in 20 links and iron 8" bears in 690 in 11 links. Corner re-established by W. Loftus, Ripco Surveyor, in 1962. ran traverse from sec. corner 7 and 8, 17, 18 to section corner 17, 18, 19 and 20. Computed distance 81.558 chains, at bearing S 181 17" 0" set quarter corner equidistantly, at 40.708 chains south. marked 1875- Tamarack 8" in 46° in 33, links and Tamarack 5" in 24° in 52, links. set 2 1/2" iron pipe.

Description of corner evidence found:
 Recovered 2 1/2" iron pipe with brass cap in excellent condition, although it did not have a cross bar at base, cap stamped:

Recovered Tamarack 8" (10") in 46° in 33, links, scribed S18 1/4° E.
 Tamarack 5" (7") in 24° in 52, links, scribing not legible.



Description of monument and accessories I established to perpetuate the original location of this corner.
 Moved corner from muck, installed a cross bar in base and reset it in same hole.
 Monument projects 20" above ground.
 No additional accessories established.
 Monument and 1875's painted blue.

Dated at Oneida, Wis., this 24th day of September, 1976

Signature: *Philip W. Hansen* Title: Registered Land Surveyor, Registration No. 2498
 (County Surveyor, Registered Land Surveyor, or other duly authorized official)

Office of Register of Deeds, County of Oneida
 Instrument was filed in this office for record on the 24th day of November, 1976 at 10:35 o'clock P.M.

Signature: *Terese Terage Kuehn*
 (Register of Deeds)

By: _____ Deputy

3709182000