

CERTIFIED LAND CORNER RESTORATION

Index No. **P-7**

State of Wisconsin

ss.

County of Oneida

I Phillip T. Hansen, do hereby

certify that on the 14th day

of April, 19 76, I found

evidence of the C 1/4

corner of Section 20

Township 37, North, Range

9 East, Fourth Principal Meridian,


as described hereon; and that from this evidence

I established a new monument and accessories

as described hereon to perpetuate the original

location of this corner.

T37N R09E

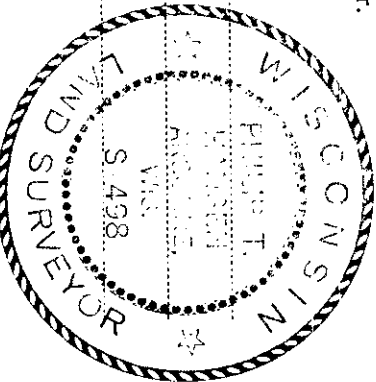

History of original corner establishment: Corner established by St. Regis Surveyors in 1961. Ran a random line west from E 1/4 corner, 89.92 chains to close out 92 lks North of W 1/4 corner. Set center 1/4 corner pin in road at 44.44 chains. Corrected bearing N 87° 31' W at intersection of N-S 1/4 line. Set reference post 50 lks south of pin in road. Marked BTs - Maple 6" S 24° E 120.4 lks and W. Birch 5" N 23° W 1.01 chs.

Description of corner evidence found: Recovered 1" iron pipe with aluminum cap, 50 lks south of corner (true corner). Cap stamped C 1/4, 50 lks due North, Ripco. Found no evidence of pin in Pine Road. Road newly recovered with black top. Determined corner position from intersection of ties to reference pipe and BTs. Recovered BTs - W. Birch 5" (6") N 23° W 1.01 chs, scribing partly visible. Maple 6" (7") S 24° E 1.204 chs, scribing partly visible.

Description of monument and accessories I established to perpetuate the original location of this corner.

As reference post was in poor condition, set a new 2 1/2" iron pipe with brass cap in its

place. N. Corner projects 18" above ground. Cap stamped.

N80 Hi line pole #3709 - 20 WT, N 14° W 37.5 lks.

Set a railroad spike at true corner, 6" below surface of blacktop.

BTs and witness Corner painted blue.

Dated at Rhineland, Wis., this 29th day of June, 1976

Signature Phillip T. Hansen Title Registered Land Surveyor Registration No. S-498

(County Surveyor, Registered Land Surveyor, or other duly authorized official)

Office of Register of Deeds, County of Oneida, I hereby certify that the within

instrument was filed in this office for record on the 23rd day of July, 1976

at 1:00 o'clock P.M.

By Doris Verage-Freeman (Register of Deeds) Deputy

3709202020

O = Corner monument restored.

