


US PUBLIC LAND SURVEY MONUMENT RECORD

Per Wis. Admin. Code § A-E 7.08, a U.S. public land survey monument record shall be prepared and filed with the county survey records as part of any land survey within 60 days of setting or accepting the corner, which includes or requires the perpetuation, restoration, or use of a U.S. public land survey corner and when any of the situations in Wis. Admin. Code § A-E 7.08(1)(a), (b) or (c) arise.

3(a) Corner Identification:	Observed Coordinates:
Found 2" iron pipe	N: 186531.15
South 1/4 corner	E: 321330.61
Section 12	Datum: NAD83(2011)
Township 37 North	GNSS Control: WISCRS
Range 10 East	NETWORK
4th Principal Meridian	GNSS Method: RTK-Direct
Town of Stella	Verification Method: 2
Oneida Co., WI	

CORNER ID:
3710120020

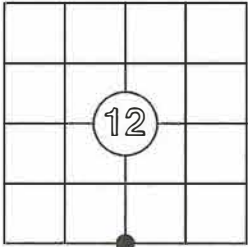

Establishment of Original Corner


Corner Set: Wood Post
Original Surveyor: Wm. Daugherty
Date of Survey: June, 1863
Aspen 7", N 34° W, 38 lks
Aspen 12", S 10° W, 14 lks

The coordinate value has been verified by at least one of the following methods:

1. Comparison to a previously determined GNSS determined published value;
2. The value is the average of two or more GNSS observations at markedly different times;
3. One or more distances were measured to the corner from offset GNSS observed locations, set and observed per No. 2 methods.

3(b)((c)(d)(f)(g)(h))

- 10/1/1959 - Hugh Crawford, Cadastral Surveyor, Bureau of Land Management completes an Extension Survey to include omitted lands in the Original Survey of Section 12-37-10. At the proportionate distance between the southwest corner and the southeast corner of the section, he set a 2" x 28" iron pipe with a brass capped marked to show the location. I also found the rotten stump of his 5" maple and the worn "+" on the top of a boulder. See the BLM field notes in the Oneida County Land Information office.
- 11/14/1990 - Todd Loftus, S-1523, finds the "BLM monument".
- 7/11/1992 - Glen Barker, S-1682, finds the "GLO Monument".
- 9/7/2025 - I, Anthony Jones, S-2508, found a 2" iron pipe along the north side of a woods trail. There was no cap on the pipe. As I was making the observation and new ties, the owner to the north, Richard French, came walking through the woods behind me and scared the crap out of me. He said that the pipe has been there for as long as he can remember but he'd never seen a cap on it. It fits with the BLM, Loftus and Barker dimensions to the southwest corner of Section 12, which I excavated and confirmed the location.

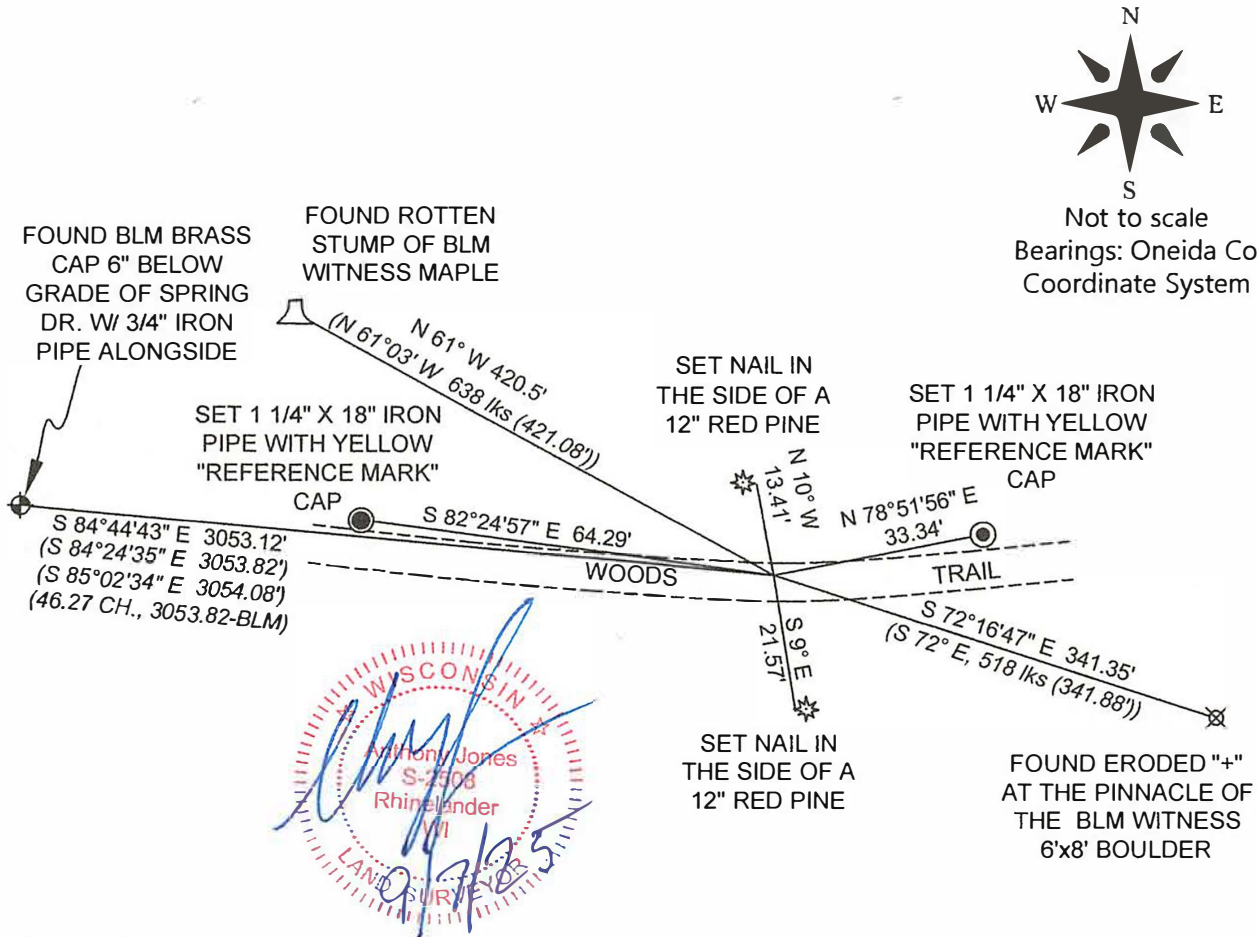

3(i) I, Anthony R. Jones, Wisconsin Professional Land Surveyor No S-2508, hereby certify that the corner location shown on this record was determined by me, and that this U.S. Public Land Survey Monument Record is correct and complete to the best of my knowledge and belief.