

CERTIFIED LAND CORNER RESTORATION

Index No. H-1

State of Wisconsin } ss.
County of Oneida


I Philip W. Hansen, do hereby certify that on the 16th day of September, 1976, I found evidence of the S 1/4 corner of Section 12 and 7 Township 37 North, Range 10 East, Fourth Principal Meridian, as described hereon; and that from this evidence I established a new monument and accessories as described hereon to perpetuate the original location of this corner.

Resident witnesses:


Alan Parker

Jim Martin

Herb Johnson

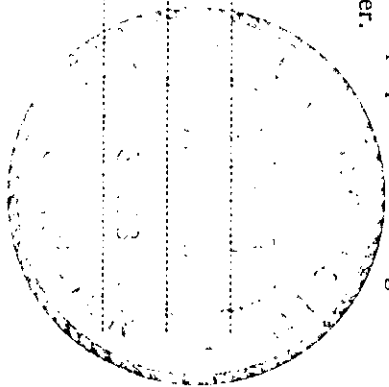

1976 FILE

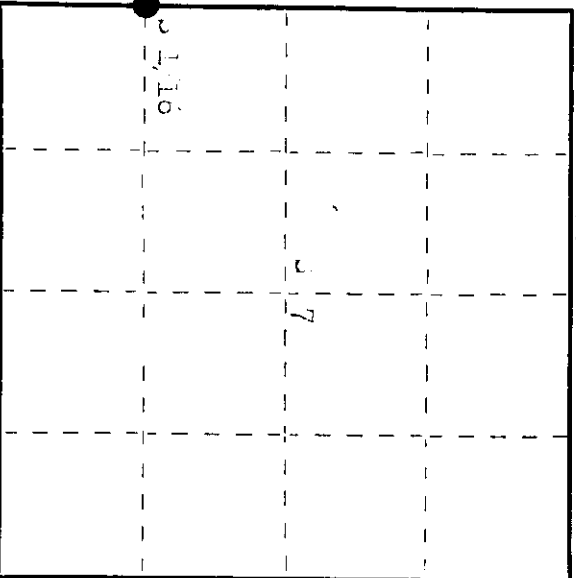

○ = Corner monument restored.

History of original corner establishment:

No notes on record regarding this corner.

Description of corner evidence found:

Recovered a 4" tamarack post, squared and scribed 1/8" x 1/8" iron nail in very poor condition. No nails were in evidence at this corner.

Description of monument and accessories I established to perpetuate the original location of this corner.

replaced tamarack post with 1" iron pipe with brass cap stamped: Monument project 18" above ground.
S 1/4 - Tamarack 8" x 8" 77.2 links, scribed 1/16" x 1/16" diameter 3" x 25" x 85.4 links, scribed 1/16" diameter and as painted blue.
S 1/4 16 10 12 7 11
S 1/4 16 10 12 7 11
1976
01-1-76

Dated at Oneida, Wis., this 3rd day of September, 1976.

Signature Philip W. Hansen Title Registered Land Surveyor Registration No. 2498
(County Surveyor, Registered Land Surveyor, or other duly authorized official)

Office of Registrar of Deeds, County of Oneida at 9th day of March, 1976
at 10:30 o'clock P. M. I hereby certify that the within instrument was filed in this office for record on the 16th day of September, 1976

Anna Virginia Fischer
(Registrar of Deeds)

By: _____ Deputy

3710121000