

State of Wisconsin

County of Oneida } ss.



I, Phillip T. Hansen, do hereby certify that on the 2nd day of March, 1978, I found evidence of the N 1/16 corner of Sections 31 & 36 Township 37 North, Range 10 & 11 East, Fourth Principal Meridian, as described hereon; and that from this evidence I established a new monument and accessories as described hereon to perpetuate the original location of this corner.

Resident witnesses:

Glen Barker

Jim Claflin

Herb Wagoner

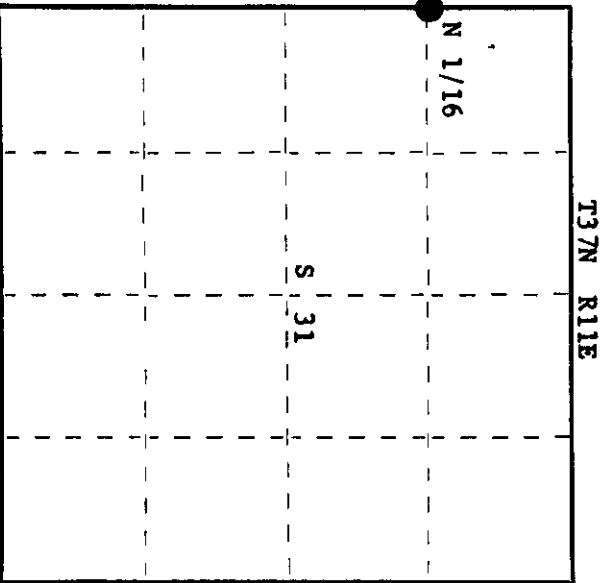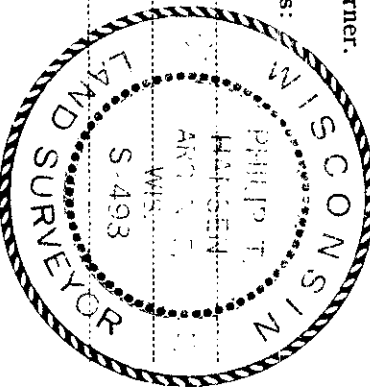

○ = Corner monument restored.

History of original corner establishment:

Corner established by D.H. Vaughan in 1906.
Corner recovered by H.C. Lawrence, Registered Land Surveyor, in 1958. Set new cedar post from which white ash 14" bears N53°W, 16 links and white ash 6" N75°E, 17 links.

Description of corner evidence found:

Recovered H.C. Lawrence's 4" cedar post squared and scribed N 1/16 - S31 - N 1/16 - S36, standing in poor condition.

Recovered OBT's - white ash 14" (16") N53°W, 16 links, scribed BT.
white ash 6" (9") N75°E, 17 links (16.5 links), scribbling grown over.

Description of monument and accessories I established to perpetuate the original location of this corner.

Replaced post with a 1 1/2" iron pipe with 2" brass cap, stamped:
Projects 18" above ground.

NBT's - Sugar 9" N79°W, 39.9 links
Sugar 10" S38°W, 44.4 links
scribed 1/16 BT.

737N R11E
36 31
E N 1/16
CPI-1978

Dated at Rhineland, Wis., this 23rd day of March, 1978

Signature Phillip T. Hansen Title Registered Land Surveyor Registration No. S-498
(County Surveyor, Registered Land Surveyor, or other duly authorized official)

Office of Register of Deeds, County of Oneida
at 10:30 o'clock AM on the 10th day of April, 1978
I hereby certify that the within instrument was filed in this office for record on the

Donna George Kuehn
(Register of Deeds)

By _____ Deputy

3710363000