

CERTIFIED LAND CORNER RESTORATION

Index No. C-8


State of Wisconsin

County of Oneida } ss.


History of original corner establishment:
No records of any previous survey.

I Phillip T. Hansen, do hereby certify that on the 16th day of January, 1980, I ~~found~~ relocated the EC 1/16 corner of Section 5 Township 37, North, Range 11 East, Fourth Principal Meridian, as described hereon; and that from this evidence I established a new monument and accessories as described hereon to perpetuate the original location of this corner.

Resident witnesses:
Glen Barker
Jim Claflin
Herb Wagoner

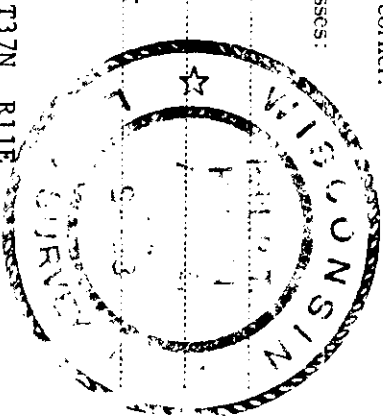

T37N R11E

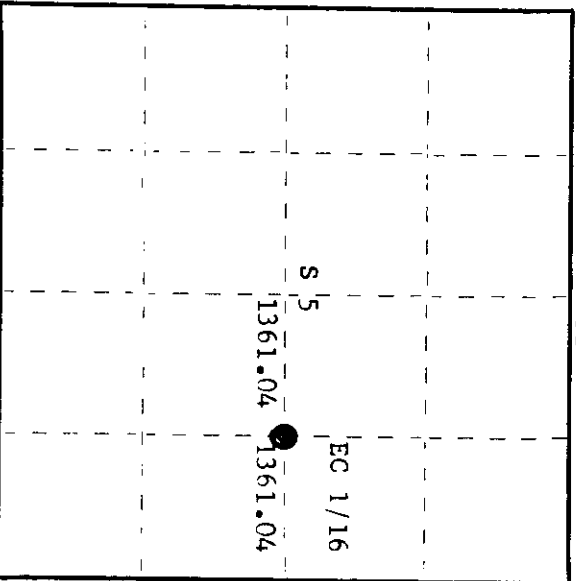

○ = Corner monument restored.

Description of corner evidence found:

No evidence of any corner recovered.
Corner established by traverse and computation. Ran traverse from S 1/4 to N 1/4 and from W 1/4 to E 1/4 to establish the C 1/4. Computed distance from C 1/4 to E 1/4 is 2722.08 feet at bearing S 89° 34' 58" W. Set EC 1/16 at 1361.04 feet intermediate.

Description of monument and accessories I established to perpetuate the original location of this corner.

Set a 1-1/2" iron pipe with 2" brass cap, stamped:
Monument project 18".
Marked NBT's - Cedar 6" S72°E 13.26 feet
Hemlock 8" S76°W 25.45 feet
both scribed 1/16 BT
S498
T37N R11E
EC 1/16 S 5

CPI-1980

Dated at Rhineland, Wis., this 28th day of January, 1980.

Signature: Phillip T. Hansen Title: Registered Land Surveyor Registration No. S-498
(County Surveyor, Registered Land Surveyor, or other duly authorized official)

Office of Register of Deeds, County of Oneida
Instrument was filed in his office for record on the 11th day of February, 1980
at 2:15 o'clock P.M.

Signature: Donna Verage Tucker
(Register of Deeds)

By: _____ Deputy

3711052010