

CERTIFIED LAND CORNER RESTORATION

Index No. **G-5**

State of Wisconsin

County of Oneida } ss.

I Phillip T. Hansen, do hereby certify that on the 2nd day of February, 1978, I found evidence of the Quarter corner of Section 7 & 8 Township 37, North, Range 11 East, Fourth Principal Meridian,



as described hereon; and that from this evidence I established a new monument and accessories as described hereon to perpetuate the original location of this corner.

Resident witnesses:

Glen Barker

Jim Clafin

Herb Wagoner

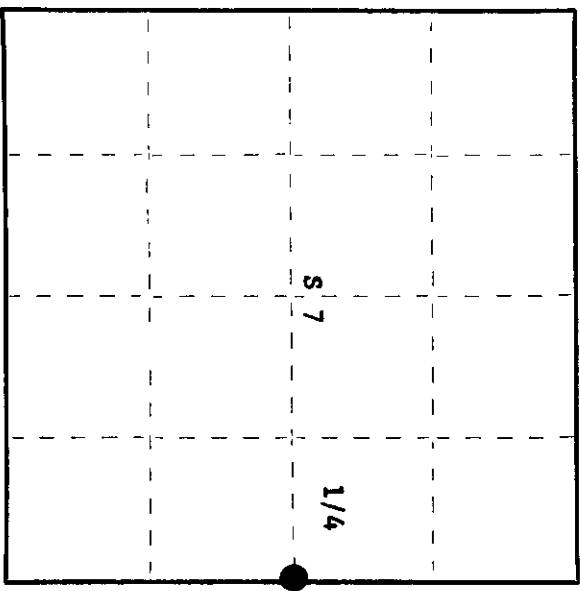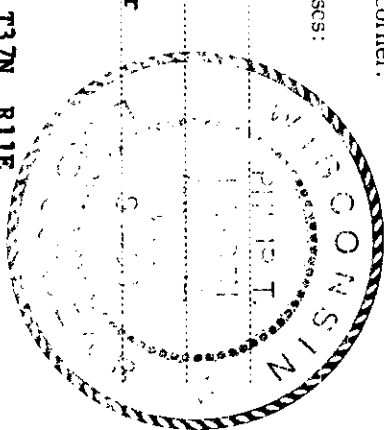

○ = Corner monument restored.

History of original corner establishment:

Original corner established by Wm. E. Dougherty, Deputy Surveyor, in 1859 from which Tamarack 9" bears S45°W, 18 links and Tamarack 8" bears S40°E, 12 links. H.C. Lawrence, Registered Land Surveyor, recovered an old post here in 1947. Set new cedar post, but no record of any BT's.

Description of corner evidence found:

Recovered Lawrence's 4" cedar post, scribed 1/4S S7, 1/4S S8 in very poor condition. No evidence of any BT's recovered.

Description of monument and accessories I established to perpetuate the original location of this corner.

Replaced 4" scribed cedar post with 2 1/2" Bernitsen A-1 Federal Monument (O.C.) projecting 8" above ground. Cap stamped:
Drove support stakes beside monument.
Marked NBT's - Black Spruce 6" S12°E, 36.4 links S498
Black Spruce 6" S71°W, 28.3 links T37N
Black Spruce 6" N42°W, 12.3 links 1/4 S7+S8
Black Spruce 6" N85°E, 28.6 links R11E
all scribed 1/4 BT.
Corner sets in a large black spruce swamp. 1978

Dated at Rhineland Wis., this 7th day of February, 1978

Signature Phillip T. Hansen Title Registered Land Surveyor Registration No. S-498
(County Surveyor, Registered Land Surveyor, or other duly authorized official)

Office of Register of Deeds, County of Oneida at 8:45 o'clock P. M. I hereby certify that the within instrument was filed in this office for record on the 8th day of February, 1978

Dorrie Leverage Fuchs
(Register of Deeds)

By _____ Deputy

000020112