

CERTIFIED LAND CORNER RESTORATION

Index No. **J-19**



State of Wisconsin

County of Oneida } ss.

I Philip T. Hansen, do hereby certify that on the 24th day of October, 1975, I found evidence of the Quarter corner of Sections 11 and 14 Township 37 North, Range 11 East, Fourth Principal Meridian, as described hereon; and that from this evidence I established a new monument and accessories as described hereon to perpetuate the original location of this corner.

Resident witnesses:

Glen Barker  
Jim Claflin

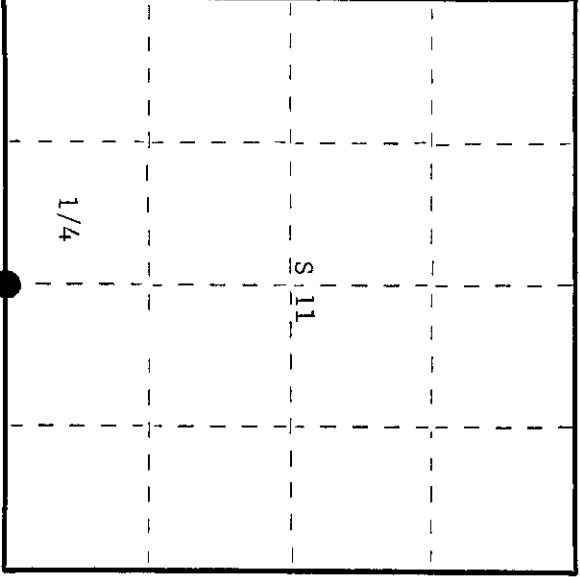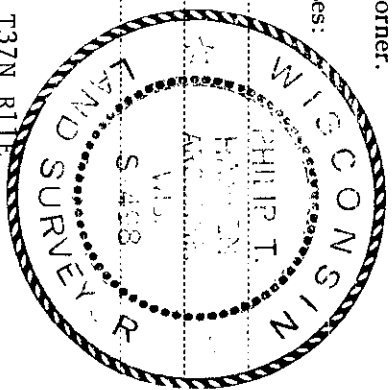

○ = Corner monument restored.

History of original corner establishment:

Original corner established by Wm. E. Dougherty, Deputy Surveyor, in 1859 from which white birch 8" bears S47°W, 13 links and white birch 10" bears N47°E, 30 links. This corner recovered by J. J. Melendy, Gagen Lumber Company surveyor. Set 4 x 4 cedar post from original BT's: Birch N47°E 30 links, green and still standing. Made NBT's: Pine stump S74°E 38-1/2 links and pine stump 40" S64-1/2°W 55 links. H.C. Lawrence, Registered Land Surveyor, recovered Melendy's pine stump S64-1/2°W in 1948. Set new cedar post and marked NBT's: White birch 10" N85°W 28 links, White birch 10" N10°W 38 1/2 links, and Hemlock 14" N60°W 27 links.

Description of corner evidence found:

Recovered Lawrence's 4" cedar post, squared and scribed 1/4S S11, 1/4S S14 in fair condition. Also an old squared post lying next to it.  
Recovered OBT's: White birch 10" N85°W 28 links - now down and decayed, Hemlock 14" N60°W 27 links - scribed NBT, and White pine stump 36" S65°W 55 links - scribed 1/4S BT.

Description of monument and accessories I established to perpetuate the original location of this corner.

Replaced 4" cedar post with 2-1/2" iron pipe with brass cap stamped - S498 T37N R11E  
Post projects 18" above ground.  
NBT: Cedar 8" S36°E 28.6 links - scribed 1/4 BT. S11  
Pipe and BT's painted blue. 1/4 S11

CPI-1975

Dated at Rhinelander, Wis., this 6th day of November, 1975.

Signature: *Philip T. Hansen* Title: Registered Land Surveyor Registration No. S-498  
(County Surveyor, Registered Land Surveyor, or other duly authorized official)

Office of Register of Deeds, County of Oneida  
I hereby certify that the within instrument was filed in this office for record on the 11th day of November, 1976 at 10:00 o'clock P.M.

Signature: *Dorrie Lorange Fiehn*  
(Register of Deeds)

By: Deputy