

CERTIFIED LAND CORNER RESTORATION



Index No. J-24

State of Wisconsin

County of Oneida } ss.

I Phillip W. Hansen, do hereby certify that on the 13th day of August, 1976, I found evidence of the corner of section 12 & 13 Township 37 North, Range 11 East, Fourth Principal Meridian, as described hereon; and that from this evidence I established a new monument and accessories as described hereon to perpetuate the original location of this corner.

Resident witnesses:  
Glen Barker  
Jim Claffin  
Herb Lagoner

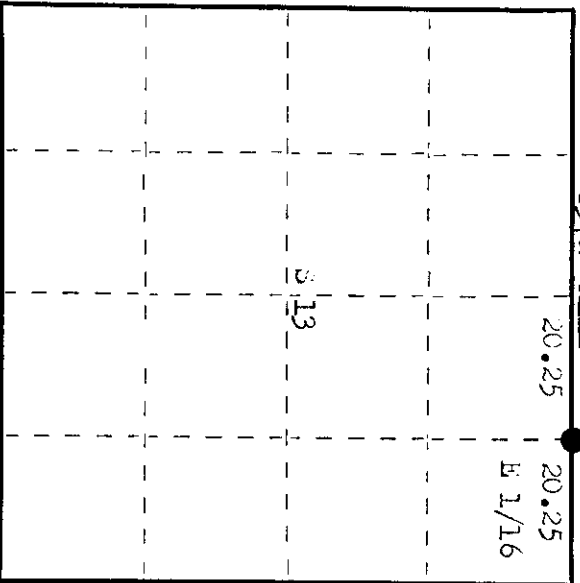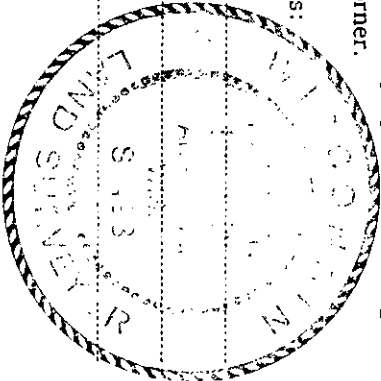

○ = Corner monument restored.

History of original corner establishment:

Corner established by J.J. Melendy, Uagen Lumber and Cedar Company surveyor, in 1916. Set cedar post at 20.25 chains, equidistant between 1/2 corner and section corner. Set 5 x 5" cedar post and marked 3T's - Cedar 14" N 32° W, 21.5 links; cedar 12" N 55° E 16 links. Corner recovered by H.C. Lawrence, Registered Land Surveyor. Recovered 3T's. Set new cedar post, 4".

Description of corner evidence found:

Recovered Lawrence's 4" cedar post, squared and scribed 24, N 1/16 S13, N 1/16 in poor condition. Also recovered an old squared cedar post 1 1/2" beside it. Recovered 3T - Cedar 14" N 32° W 21.5 links, now a decayed stump. One mark visible. Cedar 12" N 55° E 16 links, now blown down and dead. One scribe mark visible, not legible.

Description of monument and accessories I established to perpetuate the original location of this corner.

replaced cedar post with 1 1/2" OD iron pipe with 2" brass cap stamped:  
monument projects 24" above ground. 2498  
3T's - Cedar 8" N 19° W, 37.7 links, scribed 1/16 BT. 137N R11E  
Cedar 10" N 52° E 58 links, scribed 1/16 BT. E 1/16 S 13  
monument and 3T's painted blue. CPT-1976

Dated at Rhinelander, Wis. this 31st day of August, 1976

Signature: Phillip W. Hansen Title: Registered Land Surveyor, or Registration No. 2498  
(County Surveyor, Registered Land Surveyor, or other duly authorized official)

Office of Register of Deeds, County of Oneida  
Instrument was filed in this office for record on the 23rd day of September, 1976  
at 1:00 o'clock P.M.

Doree W. Berger  
(Register of Deeds)

By: \_\_\_\_\_ Deputy

010012111M