

CERTIFIED LAND CORNER RESTORATION

Index No. **G-23**

State of Wisconsin

County of Oneida } ss.

I Phillip T. Hansen do hereby certify that on the 16th day of August, 1976, I found evidence of the C 1/4 corner of Section 12 Township 37 North, Range 11 East, Fourth Principal Meridian,



as described hereon; and that from this evidence I established a new monument and accessories as described hereon to perpetuate the original location of this corner.

Resident witnesses:

Wen Barker

Jim Staffin

Herb Macomber

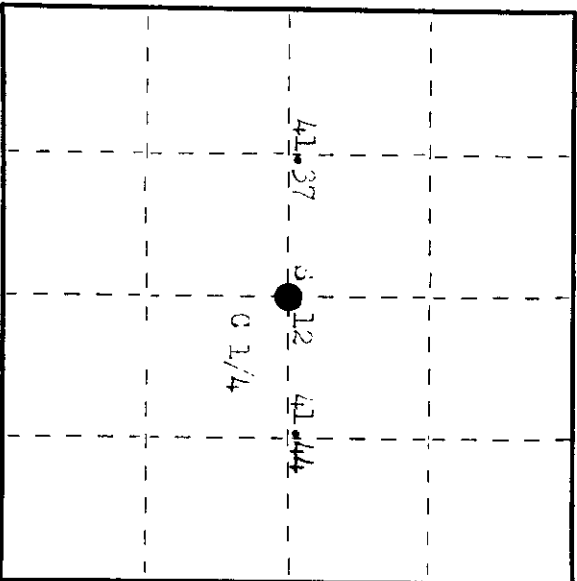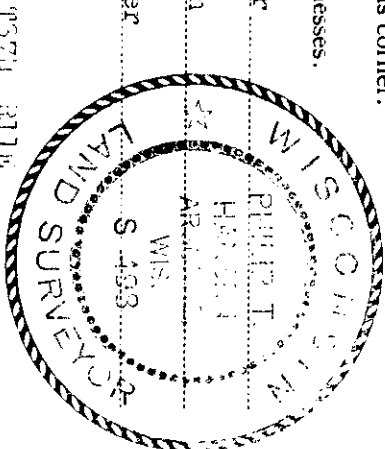

○ = Corner monument restored.

History of original corner establishment:

Corner established by Wm. J. Jaine, Oneida County Surveyor, in 1935. The 1/4 lines to establish corner. Set cedar post and marked ST's - spruce 5" x 65" .. 6 links, spruce 5" x 45" .. 0 links and spruce 5" x 31" .. 23 links.

Description of corner evidence found:

Recovered 6" cedar post, squared and scribed 0 1/4 x 3/4. Post was lying down under the moss.

Recovered OST's - spruce 5" x 35" .. 0 links, now dead and down, scribed 0 1/4 ST.

spruce 5" x 45" .. 0 links, now 3' decayed stump, some scribe marks.

spruce 5" x 31" .. 20 links, now a decayed stump.

From cross ties had hole to recover hole, bearings and distances fit good.

Description of monument and accessories I established to perpetuate the original location of this corner.

Replaced post with 2" diameter A-1 Federal monument stamped: monument projects 13" above ground.

Drove support stakes beside monument.

ST's - Tamarack 1 1/2 x 30" .. 32.0 links, scribed 1/40 ST.

Tamarack 7" x 32" .. 23 links, scribed 1/40 ST.

Tamarack 5" x 45" .. 51.0 links, scribed 1/40 ST.

Monument and ST's painted blue.

3498

137th R11E

41.37 12

0 1/4

0 1/4

Dated at Oneida, Wis., this 1st day of September, 1976.

Signature: *Phillip Hansen* Title: Registered Land Surveyor, or other duly authorized official Registration No. S-498

County Surveyor, Registered Land Surveyor, or other duly authorized official

Office of Register of Deeds, County of Oneida. I hereby certify that the within instrument was filed in this office for record on the 29th day of September, 1976, at 2:30 o'clock P.M.

Doris Verage Fuchs
(Register of Deeds)

By: Deputy

0102211122020