

CERTIFIED LAND CORNER RESTORATION

Index No. **G-22**

State of Wisconsin

County of Oneida } ss.

I Phillip T. Hansen, do hereby certify that on the 16th day of August, 1976, I found evidence of the C 1/16 corner of Section 12

Township 37, North, Range 11 East, Fourth Principal Meridian,



as described hereon; and that from this evidence I established a new monument and accessories as described hereon to perpetuate the original location of this corner.

Resident witnesses:

Glen Parker

Jim Claffin

Herb Johnson

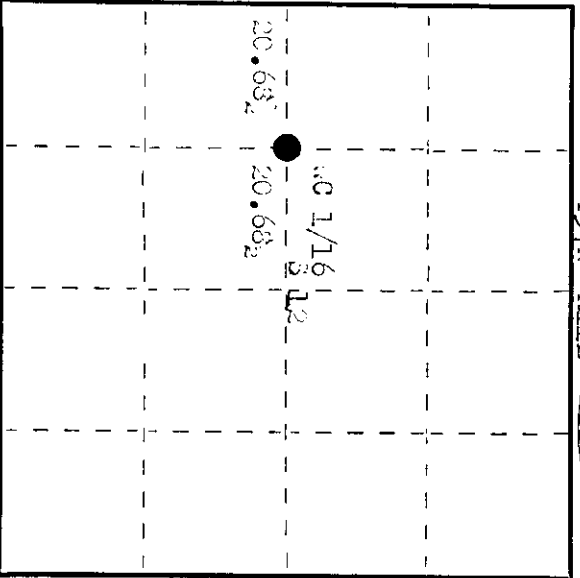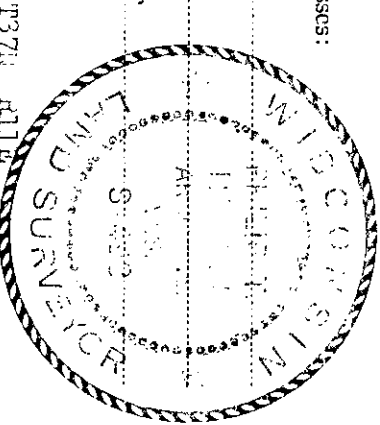

○ = Corner monument restored.

History of original corner establishment:

Corner established by V.L. Jaine, Oneida County Surveyor, in 1935. The line was set by lines to establish the C 1/4 corner. Set the C 1/16 corner at 20.63 chains east of C 1/4 corner equidistant. Set cedar post and marked BT's - Cedar 14" x 70" x 19 1/2 links, Cedar 10" x 87 1/2" x 15 1/2 links, Yellow Birch 12" x 14 1/2" x 18 links.

Description of corner evidence found:

Recovered pieces of Jaine's cedar post, laying in the muck. Recovered Cedar 14" x 70" x 19.5 links, now a cut off stump, 4' high scribed 1/8" BT. Cedar 10" (12") x 87" 30" x 15.5 links, scribed 1/8" BT. Yellow Birch 22" x 14" 30" x 18 links, plow over and dead, scribing still visible. Using Jaine's BT's as cross ties, located original position of post.

Description of monument and accessories I established to perpetuate the original location of this corner.

Replaced corner post with 1 1/2" OD iron pipe with 2" brass cap stamped: 3498
 Monument projects 4" above ground. T37N R11E
 BT - Cedar 10" x 20" x 72.7 links, scribed 1/16 BT. C 1/16 1/2
 Monument and BT's painted blue. CH-1976

Dated at Winnelandor, Wis., this 1st day of September, 1976.

Signature Phillip T. Hansen Title Registered Land Surveyor Registration No. 3-498
 (County Surveyor, Registered Land Surveyor, or other duly authorized official)

Office of Register of Deeds, County of Oneida, I hereby certify that the within instrument was filed in this office for record on the 19th day of September, 1976, at 2:30 o'clock P. M.

Debra Leverage Tucker
 (Register of Deeds)

By Debra Leverage Tucker Deputy

371122030