

CERTIFIED LAND CORNER RESTORATION

Index No. **L-21**


State of Wisconsin

County of Oneida } ss.


I, Phillip T. Hansen, do hereby certify that on the 19th day of August, 1976, I found evidence of the quarter corner of section 13 and 14

Township 37 North, Range 11 East, Fourth Principal Meridian, as described hereon, and that from this evidence I established a new monument and accessories as described hereon to perpetuate the original location of this corner.

Resident witnesses:
Glen Barker
Jim Claffin
Herb Legomer

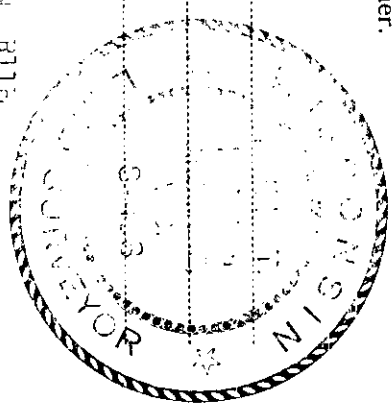

1976 R112

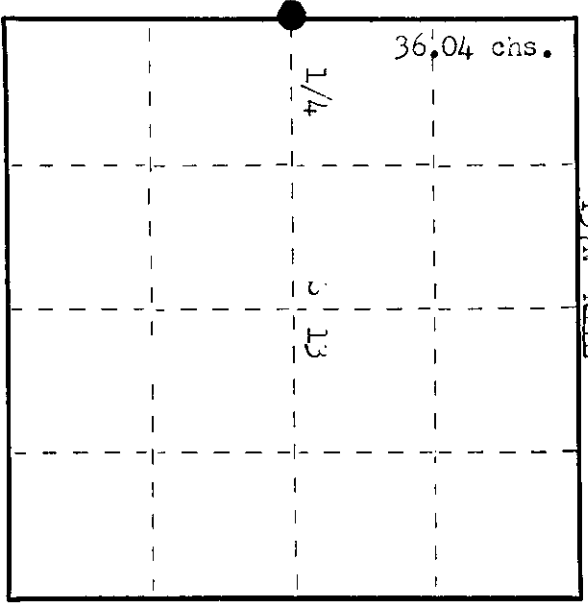

○ = Corner monument restored.

History of original corner establishment:

Original corner established by Wm. E. Dougherty, Deputy Surveyor, in 1859, from which Y. Pine 24" bears S 27° E 17 links and white pine 20" bears N 79° E 6 links.

Corner restored by J.J. Melendy, Jagen Lumber & Cedar Company Surveyor, in 1918, recovered point of old post and original pine stump in 79° N 6 links. Set new cedar post and marked NPT's - pine stump 26" S 37° W 46 links and pine stump 30" N 66° E 25 1/2 links.

Corner recovered by W. W. Maine, Oneida County Surveyor, set 2 1/2" iron pipe.

Description of corner evidence found:

1976 R112
14 1/4 13

Recovered Maine's 2 1/2" iron pipe with brass cap stamped: Also recovered pieces of Melendy's old post beside it. Recovered "original" white pine stump 20" N 79° W 6 links, decayed, no scribing.

- 1. Pine stump 44" S 27° E 17 links - our measurements are 7 links.
- Pine stump 20" S 37° W 46 links, scribed 1/4 B.P.
- Pine stump 30" N 66° E 25.5 links, scribed 1/4 B.P.
- Pine 20" S 68° W 57.3 links, scribed 1/4 B.P.

Description of monument and accessories I established to perpetuate the original location of this corner. As Maine's pipe was recovered in perfect condition, we left it in place.

Monument projects 28" above ground.
NPT - white line 20" N 84° W 73.5 links, scribed 1/4 B.P.
Cedar 0" N 34° E 43 links, scribed 1/4 B.P.
Monument and NPT's painted blue.

Dated at Oneida, Wis., this 1st day of September, 1976

Signature *Phillip T. Hansen* Title Registered Land Surveyor Registration No. 3498
(County Surveyor, Registered Land Surveyor, or other duly authorized official)

Office of Register of Deeds, County of Oneida
Instrument was filed in this office for record on the 29th day of September, 1976
at 2:30 o'clock P.M.

Doris Teresa Fischer
(Register of Deeds)

By Deputy