

CERTIFIED LAND CORNER RESTORATION

Index No. N-16



State of Wisconsin

County of Oneida } ss.

I Phillip T. Hansen do hereby certify that on the 21st day of November 1975, I found evidence of the E-1/16 corner of Sections 15 and 22 Township 37 North, Range 11 East, Fourth Principal Meridian, as described hereon; and that from this evidence I established a new monument and accessories as described hereon to perpetuate the original location of this corner.

Resident witnesses:

Glen Barker
Jim Claflin

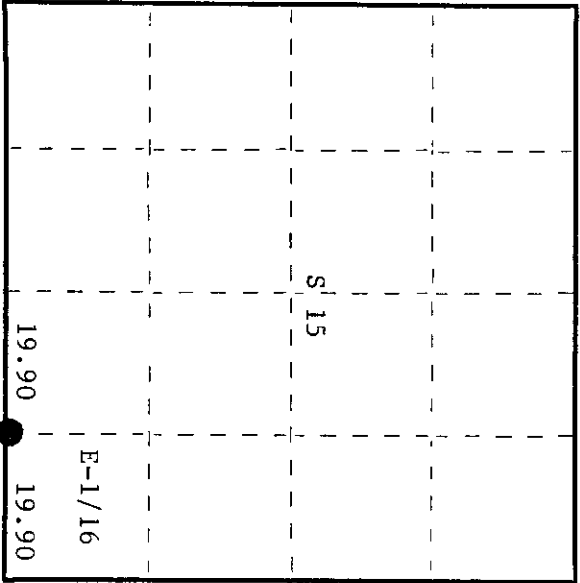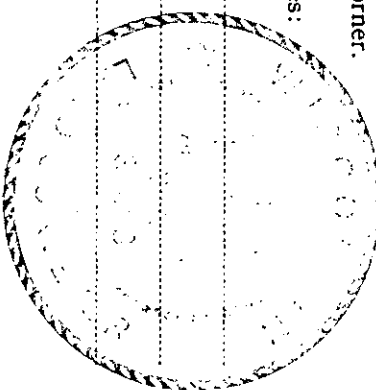

○ = Corner monument restored.

History of original corner establishment: Corner established by H.C. Lawrence, Registered Land Surveyor, in 1949. Ran a random line west (var. 0°10'W) 39.80 chains to a point 46 links north at right angles from 1/4 corner. Set E-1/16 corner at 19.90 chains intermediate, 23 links south. Set new post and marked NBT's spruce 14" S61°E, 49-1/2 links, white pine 10" N16°E 49 links.

Description of corner evidence found:

Recovered 4" cedar post, squared and scribed D-1/16 S15, E-1/16 S22 in poor condition.

Recovered OBT's - Spruce 14" S61°E 49.5 links scribed E-1/16 S22 BT - now dead.

White Pine 10" (11") N16°E 49 links scribed E-1/16 S15 BT.

Description of monument and accessories I established to perpetuate the original location of this corner.

Replaced 4" cedar post with 1" O.D. iron pipe with 2" brass cap stamped -

Pipe projects 2' above ground. S498
Placed old post next to new pipe. T37N R11E

NBT - White Birch 9" N60°W 30.6 links scribed 1/16 BT. E-1/16 S 15
S 22

Pipe, post, and BT's painted blue. CPI-1975

Dated at Rhinelander Wis. this 3rd day of December 1975.

Signature Phillip T. Hansen Title Registered Land Surveyor Registration No. S-498
(County Surveyor, Registered Land Surveyor, or other duly authorized official)

Office of Register of Deeds, County of Oneida. I hereby certify that the within instrument was filed in this office for record on the 22nd day of September 1976 at 10:00'clock M.

Dorcas Veragen Tuckin
(Register of Deeds)

By Deputy

371150010