



CERTIFIED LAND CORNER RESTORATION

Index No. N-9

State of Wisconsin }
 County of Oneida } ss.

I, Philip T. Hansen, do hereby certify that on the 15th day of July, 1975, I found evidence of the Section Corner corner of S16, S17, S20, and S21 Township 37 North, Range 11 East, Fourth Principal Meridian, as described hereon; and that from this evidence I established a new monument and accessories as described hereon to perpetuate the original location of this corner.

Resident witnesses:

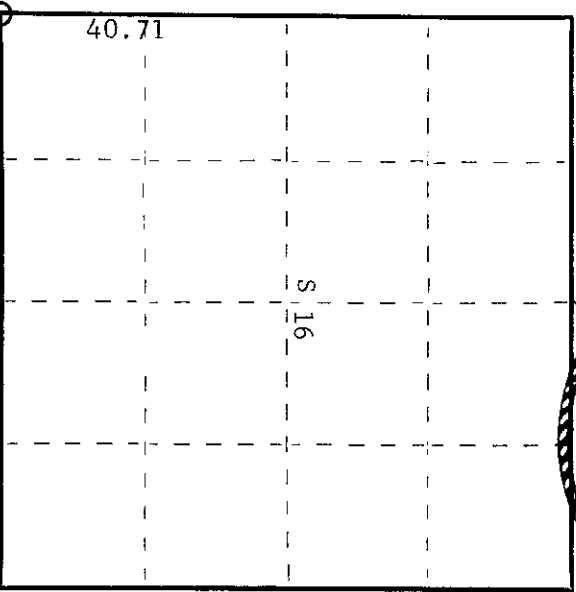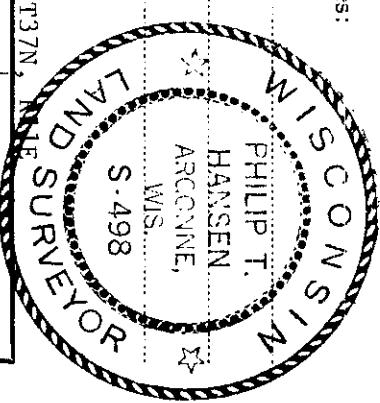

○ = Corner monument restored.

History of original corner establishment:

Original corner established by Wm. E. Dougherty, Gov't Deputy Surveyor, in 1859, from which tamarack 10", bears S55°E, 33 lks. and spruce 6", bears N45°W, 20 lks. Corner recovered by V.M. Maine, County Surveyor, in 1935. Recovered the stump of original tamarack BT. Set iron pipe and made new BT's, white pine stump 22", S30°W, 17-1/4 lks.; white birch 14", N39°E, 47 lks.; and soft maple 12", N15°E, 21-7/8 lks. Corner recovered by H.C. Lawrence, Reg. Land Surveyor in 1948. Recovered iron pipe. Recovered OBT white pine stump 22", S30°W, 17-1/4 lks., scribed S20 BT. White birch 14", N39°E, 47 lks., now a decayed stump; red maple 12", N15°E O.C., 22 lks., now an 8' stub, scribed S16 BT.

Description of corner evidence found:

Recovered 2-1/2" iron pipe w/brass cap, stamped T37N, R11E, S16, S17, S20, S21. Also recovered a 4" squared post lying on ground beside it, no scribing visible.

Description of monument and accessories I established to perpetuate the original location of this corner.

Iron pipe in good condition so left it as is.
 NBT's Red maple 6", S55°E, 43.7 lks., scribed SC BT.
 White birch 6", N38°E, 47.3 lks., scribed SC BT.

Dated at Rhinelander, Wis., this 29th day of July, 1975.

Signature: *Philip T. Hansen* Title: Registered Land Surveyor Registration No. S-498
 County Surveyor, Registered Land Surveyor, or other duly authorized official

Office of Register of Deeds, County of Oneida
 Instrument was filed in this office for record on the 1st day of October, 1975 at 3:00 o'clock P.M.

Doris Terage Kuehn
 (Register of Deeds)

By: Deputy

3711170000