

CERTIFIED LAND CORNER RESTORATION

Index No. M-7

State of Wisconsin

County of Oneida } ss.

I Phillip T. Hansen, do hereby certify that on the 15th day of June, 1977, I found

evidence of the SC 1/16 corner of Section 17

Township 37, North, Range

11 East, Fourth Principal Meridian,

as described hereon; and that from this evidence I established a new monument and accessories as described hereon to perpetuate the original location of this corner.

History of original corner establishment:

Corner established by H.C. Lawrence, Registered Land Surveyor, in 1948. Ran N-S and E-W 1/4 lines from recovered 1/4 corners to establish the C 1/4 corner. Corner established at 40.90 chains North of S 1/4 corner. Set SC 1/16 at 20.45 chains intermediate.

Description of corner evidence found:


Recovered 4" tamarack post, squared and scribed SC 1/16 S17, SC 1/16 S17 in poor condition. No evidence of any BTs recovered.

Resident witnesses:

Glen Barker

Jim Clafin

Herb Wagoner

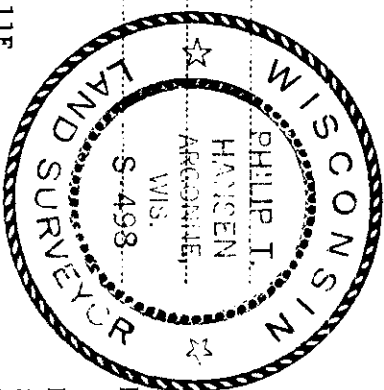

Description of monument and accessories I established to perpetuate the original location of this corner.

Set 1 1/2" iron pipe with 2" brass cap, stamped:

Monument projects 12" above ground.

Set 1 1/2" x 5' iron pipe 30 links north for a reference monument.

This projects 2 1/2' above ground.

Corner sets west 74.3 links from west rail of C & NW RR and N42°E,


2.84 chains from the SE corner of bridge.

S498

T37N R11E

SC 1/16 S17

CPI-1977

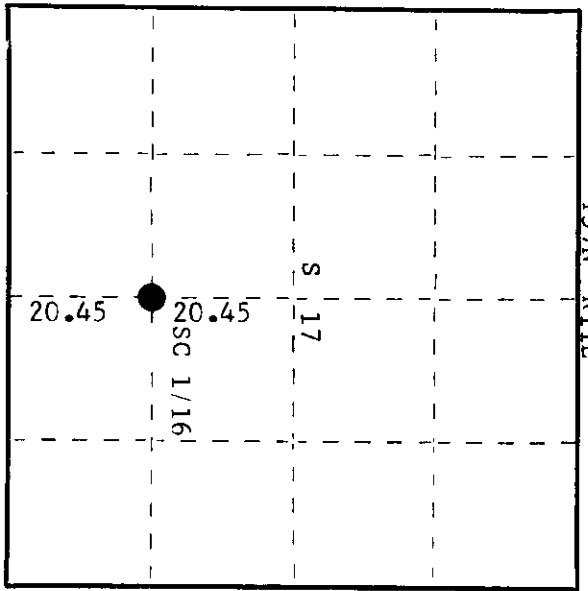

O = Corner monument restored.

Dated at Rhineland, Wis., this 20th day of June, 1977.

Signature: Phillip T. Hansen Title Registered Land Surveyor Registration No. S-498

County Surveyor, Registered Land Surveyor, or other duly authorized official)

Office of Register of Deeds, County of Oneida, I hereby certify that the within

instrument was filed in this office for record on the 30th day of June, 1977

at 9:30 o'clock a. M.

David Savage Kuehn
(Register of Deeds)

By: Joseph M. Boerner Deputy

3711171020