

CERTIFIED LAND CORNER RESTORATION

Index No. L-8

State of Wisconsin

County of Oneida } ss.

I Phillip T. Hansen, do hereby certify that on the 13th day of June, 1977, I found evidence of the EC 1/16 corner of Section 17 Township 37, North, Range 11 East, Fourth Principal Meridian,



as described hereon; and that from this evidence I established a new monument and accessories as described hereon to perpetuate the original location of this corner.

Resident witnesses:

Glen Barker

Jim Claffin

Herb Maegoner

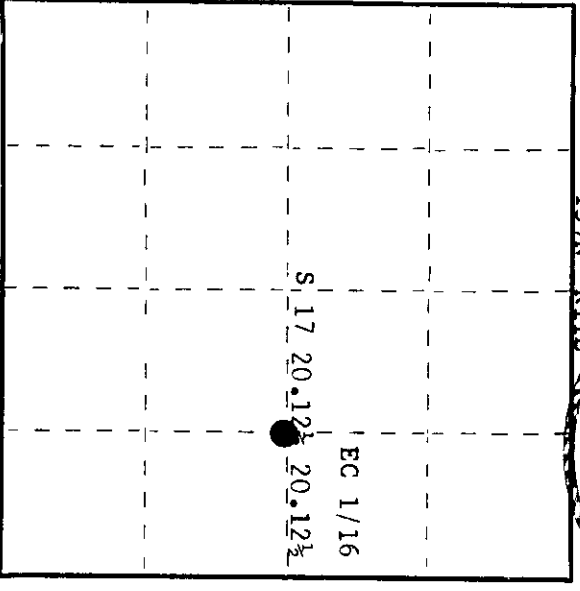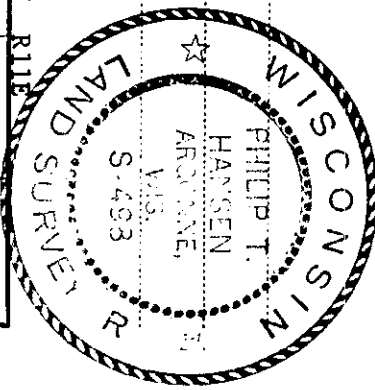

○ = Corner monument restored.

History of original corner establishment:

Corner established by H.C. Lawrence, Registered Land Surveyor, in 1948. Ran random N-S 1/4 line and the east-west 1/4 line to establish the C 1/4 corner at 40.25 chains west of E 1/4 corner and 43.36 chains east of W 1/4 corner. Set EC 1/16 at 20.12 1/2 chains equidistant. Set new post and marked NBTs - Cedar 9" N34°W, 15 links and Cedar 7" S87°E, 20 1/2 links.

Description of corner evidence found:

Recovered 5" cedar post, squared and scribed EC 1/16 S17, EC 1/16 S17 in fair condition. Recovered OBTs - Cedar 9" N34°W, 15 links, now a decayed stump. Cedar 7" (10") S87°E (S84°E) 20.5 links, scribed S17 BT.

Description of monument and accessories I established to perpetuate the original location of this corner.

Replaced cedar post with 1 1/2" iron pipe with 2" brass cap, stamped:
Monument projects 18" above ground.
Marked NBT - Cedar 14" N23°W, 42.8 links, scribed 1/16 BT.
Drove supports stakes beside monument to support it.

S498
T37N R11E
EC 1/16 S117
CPI-1977

Dated at Rhineland, Wis., this 20th day of June, 1977.

Signature Phillip T. Hansen Title Registered Land Surveyor Registration No. S-498
County Surveyor, Registered Land Surveyor, or other duly authorized official)
Office of Registrar of Deeds, County of Oneida
at 9:30 o'clock A M. I hereby certify that the within instrument was filed in this office for record on the 30th day of June, 1977.

By Joseph M. Boerner Deputy
Stana Savage Tuck
(Registrar of Deeds)

01021173