

CERTIFIED LAND CORNER RESTORATION

Index No. **0-3**

State of Wisconsin

County of Creida



ss.

I, Philip T. Hansen, do hereby certify that on the 3rd day of August, 1977, I found evidence of the NC 1/16 corner of Section 19 Township 37 North, Range 11 East, Fourth Principal Meridian, as described hereon; and that from this evidence I established a new monument and accessories as described hereon to perpetuate the original location of this corner.

Resident witnesses:

Jim Chaffin

Hert Wagoner

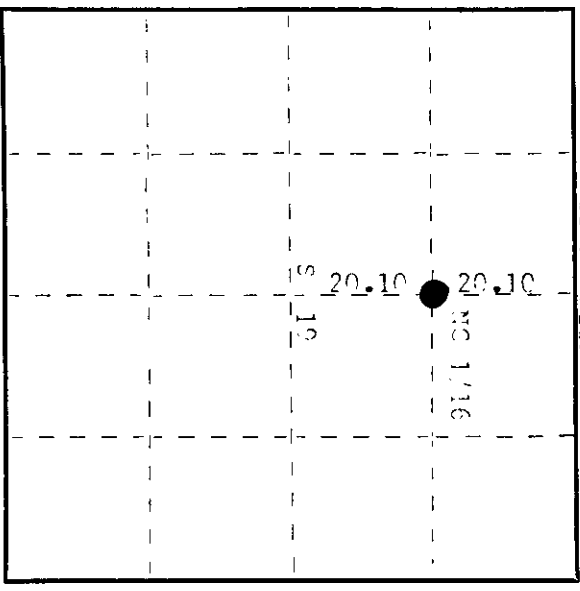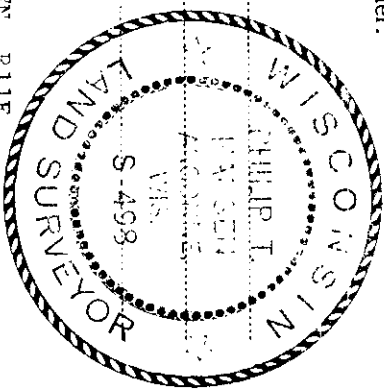

History of original corner establishment.

Corner established by H.C. Lawrence, Registered Land Surveyor, in 1951. Ran random line S50° from 1/4 corner between Section 18-19, a distance of 40.20 chains to close out 205 links at right angles east of C 1/4 corner established by D.H. Vaughan. Set NC 1/16 at 20.10 chains, offset 1.021 chains at right angles in open muskeg. Marked NRTs - Norway Pine 160 N33° 00' 193.5 links and Norway Pine 160 S78° 00' 27.5 links. Burnt Norway stump 140 - 3' 11/2" high N21° 16' 167.5 links, all on ridge bordering muskeg.

Description of corner evidence found:

Recovered 4" cedar post, squared and scribed NC 1/16 S19, NC 1/16. Sets in a 102 inch north west of small pond. Recovered CRTs - Norway 160 (22m) N33° 00' 193.5 links (194.5 links), scribed NC 1/16 S19 NRT. Norway 160 (27m) S78° 00' 27.5 links (210.5 links), scribed NC 1/16 S19 NRT.

Description of monument and accessories I established to perpetuate the original location of this corner.

Replaced cedar post with 1 1/2" iron post with 2" brass cap projecting 24" above ground. Cap scribed: No additional accessories established.

T37N R11E  
NC 1/16 S 19  
S49° - 1977

Dated at Rhineland, Wis., this 11th day of August, 1977

Signature *Philip T. Hansen* Title Registered Land Surveyor Registration No. S-498  
(County Surveyor, Registered Land Surveyor, or other duly authorized official)

Office of Register of Deeds, County of Creida  
I hereby certify that the within instrument was filed in this office for record on the 22nd day of August, 1977 at 1:15 o'clock P.M.

*Dorcas Torrey Kuehn*  
(Register of Deeds)

By \_\_\_\_\_ Deputy

3711193020