

CERTIFIED LAND CORNER RESTORATION


Index No. **R-14**

State of Wisconsin } ss.  
 County of Oneida

I Phillip T. Hansen, do hereby certify that on the 10th day of November, 1975, I found evidence of the W-1/16 corner of Sections 22 and 27 Township 11 East, North, Range 37, Fourth Principal Meridian,

as described hereon; and that from this evidence I established a new monument and accessories as described hereon to perpetuate the original location of this corner.

Resident witnesses:  
 Glen Barker  
 Jim Clafflin

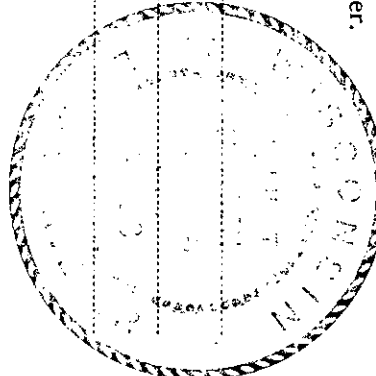


History of original corner establishment:  
 Corner established by V.M. Maine, County Surveyor. Set corner at 21.08 1/2 chains, equidistant between 1/4 corner between Sections 22 and 27 and Section Corner 21, 22, 27, and 28. Marked NBT's - W. pine 6", N81°W, 52 lks. and BT peak of triangular boulder 30" x 30", S52°E, 9 lks. Post sets near north R/W Fence of Soo Line Railroad.  
 Corner recovered by H.C. Lawrence, Registered Land Surveyor, in 1949. Set new cedar post.

Description of corner evidence found:  
 Recovered Lawrence's 4" cedar post, squared and scribed W-1/16 S22, W-1/16 S27 in poor condition. A rock cairn had been built around base. Maine's old stake was lying beside it.  
 Recovered OBT - W. pine 6" (13") N81°W 52 lks. scribed W-1/16 S22 BT.  
 Peak of boulder S52°E 9 lks. (23.5 lks.) This disagrees with Maine's measurement.

Description of monument and accessories I established to perpetuate the original location of this corner.  
 Replaced 4" cedar post with 1" iron pipe with 2" brass cap stamped - S498  
 Iron pipe projects 18" above ground T37N, R11E  
 Corner sets 50 lks. north of Soo Line Railroad.  
 NBT - W. spruce 8" N27°E 53.4 lks. scribed 1/16 BT.  
 Pipe and BT's painted blue.  
 W-1/16 S122  
 S127

CPI-1975

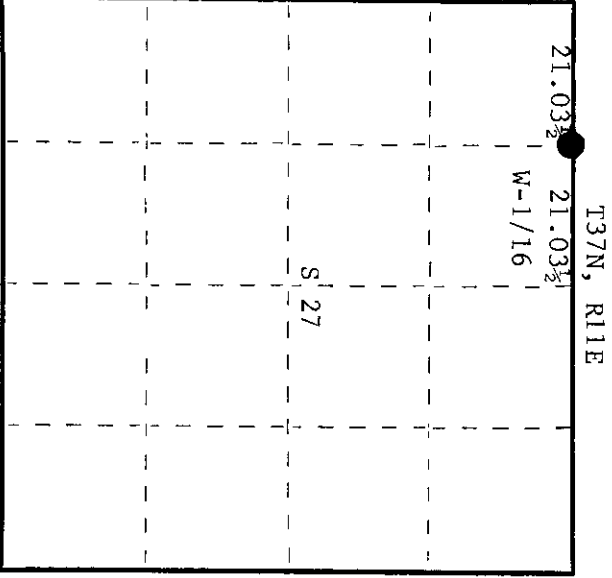

○ = Corner monument restored.

Dated at Rhinelander, Wis., this 11th day of November, 1975

Signature: *Phillip T. Hansen* Title: Reg. Land Surveyor Registration No. S-498  
 (County Surveyor, Registered Land Surveyor, or other duly authorized official)

Office of Register of Deeds, County of Oneida  
 Instrument was filed in this office for record on the 11th day of November, 1975  
 at 10:00 o'clock A.M.

Signature: *Dorva Heritage Kuehn*  
 (Register of Deeds)

By: \_\_\_\_\_ Deputy

3711220030