
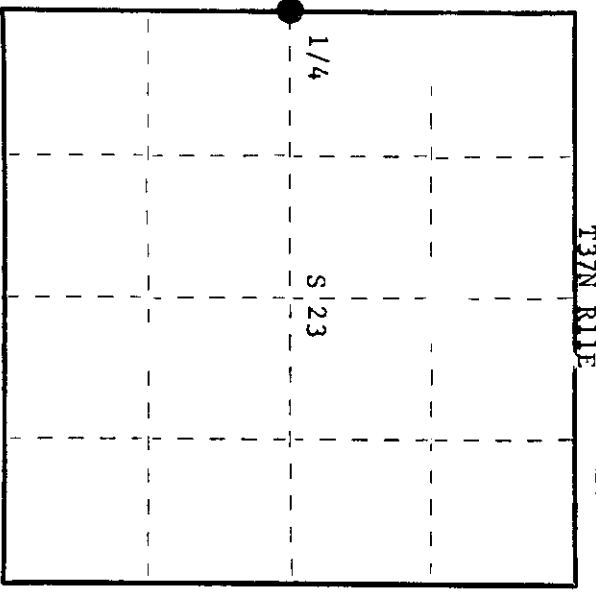


State of Wisconsin } ss.
County of Oneida

I Philip T. Hansen, do hereby certify that on the 4th day of December, 1975, I found evidence of the Quarter corner of Section 22 and 23 Township 37 North, Range 11 East, Fourth Principal Meridian, as described hereon; and that from this evidence I established a new monument and accessories as described hereon to perpetuate the original location of this corner.

Resident witnesses:
Glen Barker
Jim Clafin

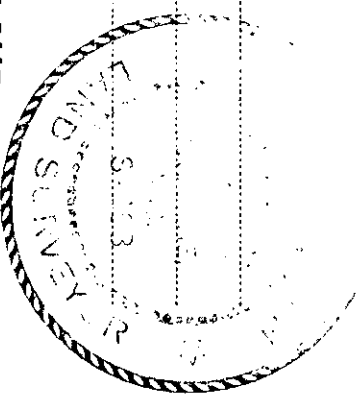

○ = Corner monument restored.

CERTIFIED LAND CORNER RESTORATION

Index No. P-17

History of original corner establishment: Original corner established by William E. Dougherty, Deputy Surveyor, in 1859 from which hemlock 6" bears N75°W, 20 links and birch bears N85°E, 10 links.

Corner recovered by J.J. Melendy, Gagen Lbr. Co. Surveyor, who claims to have found original BT's and from which he set a 5" cedar post and marked NBT's - cedar 10", S5-1/2°W, 34 links and cedar 10", S9-1/2°E, 44 links.

Corner recovered by H.C. Lawrence, Registered Land Surveyor, in 1948. Set new 6" cedar post. Also found remains of Melendy's wood post.

This corner was recovered by V.M. Maine, County Surveyor. Marked BT - balsam 10", N63°E, 80 links.

Description of corner evidence found: Recovered Lawrences 6" cedar post, squared and scribed 1/4S S22 1/4S S23, in poor condition. Recovered Melendy's old decayed post lying beside it.

Recovered OBT - Cedar 10" S51-1/2°W 34 links Now uprooted and decayed stub.
Cedar 10" S9-1/2°E (S12°E) 44.5 links Now cut-off stp. scribed 1/4S BT

There is a balsam 12" N62°E 80.5 links scribed BT (Maine's).

Description of monument and accessories I established to perpetuate the original location of this corner.
Replaced Lawrence's 6" cedar post with 2-1/2" iron pipe with brass cap stamped -
Pipe projects 18" above ground.

NBT's - Cedar 10" N79°E 109.4 links scribed 1/4 BT S498
Cedar 10" S22°E 99.7 links scribed 1/4 BT T37N R11E

Pipe and BT's painted blue.
1/4 S22 S23
CPI-1975

Dated at Rhineland, Wis., this 9th day of December, 1975.

Signature Philip T. Hansen Title Registered Land Surveyor Registration No. S-498
(County Surveyor, Registered Land Surveyor, or other duly authorized official)

Office of Register of Deeds, County of Oneida
Instrument was filed in this office for record on the 4th day of December, 1975
at 1:30 o'clock P. M.

William E. Dougherty
(Register of Deeds)

By _____ Deputy

0000222000