

CERTIFIED LAND CORNER RESTORATION

Index No. V-13

State of Wisconsin


County of Oneida } ss.

I Phillip T. Hansen, do hereby certify that on the 10th day of November, 1975, I found evidence of the Section corner of Sections 21, 22, 27, and 28 Township 37 North, Range 11 East, Fourth Principal Meridian, as described hereon; and that from this evidence I established a new monument and accessories as described hereon to perpetuate the original location of this corner.


Resident witnesses:

Glen Barker

Jim Claflin

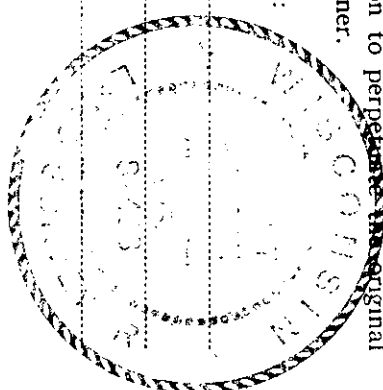

T37N, R11E

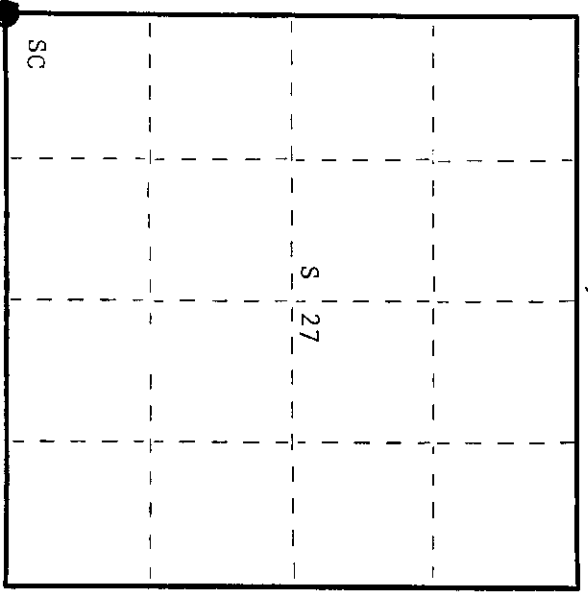

○ = Corner monument restored.

History of original corner establishment:

Original corner established by Wm. E. Dougherty, Deputy Surveyor, in 1859 from which tamarack 8" bears S64°W, 12 lks. and W. spruce bears N51°E, 14 lks. Corner re-established by V.M. Maine, County Surveyor, in 1937. Established corner by proportional measurement. Set 2-1/4" iron pipe with brass cap, stamped -

from which aspen 10" bears N56°W, 21-3/4 lks.

Aspen 8" bears N61°E, 49-1/4 lks. and aspen 8" bears S22°E, 55-3/4 lks.

Corner recovered by H.C. Lawrence, Registered Land Surveyor, in 1949.

Checked Maine's measured distance between Sections 27 and 28 with difference of 8 lks. Set 5" cedar post beside Maine's iron pipe.

Description of corner evidence found:

Recovered V.M. Maine's iron pipe with brass cap in good condition.

Recovered his OBT's - Aspen 10" N56°W 21-3/4 lks. Now a decayed stump.

Aspen 8" N61°E 49.5 lks. Now a decayed stump.

Aspen 8" S22°E 55-3/4 lks. Now a decayed stump.

Recovered Lawrence's 5" cedar post, squared and scribed S21, S22, S27, S28. This had fallen down.

Description of monument and accessories I established to perpetuate the original location of this corner.

As Maine's iron pipe was in very good condition, we left it as it was.

Set Lawrence's cedar post up beside it.

NBT's - Elm 12" N46°E 65.5 lks. Scribed SC BT.

Elm 7" S31°W 51 lks. Scribed SC BT.

Corner is north 2.71 chains from center line of Soo Line Railroad. Pipe and BT's painted blue.

Dated at Rhineland, Wis., this 11th day of November, 1975.

Signature Phillip T. Hansen Title Registered Land Surveyor Registration No. S-498
 County Surveyor, Registered Land Surveyor, or other duly authorized official

Office of Register of Deeds, County of Oneida
 Instrument was filed in this office for record on the 11th day of November, 1976
 at 10:00 o'clock A.M.

Gene George Fuchs
 (Register of Deeds)

By _____ Deputy

0000801123