



CERTIFIED LAND CORNER RESTORATION

Index No. 7-7

State of Wisconsin } ss.
 County of Oneida }

I Philip T. Hansen, do hereby certify that on the 1st day of April, 1975, I found evidence of the C-1/4 corner of Section 29 Township 37 North, Range 11 E, Fourth Principal Meridian, as described hereon; and that from this evidence I established a new monument and accessories as described hereon to perpetuate the original location of this corner.

Resident witnesses:

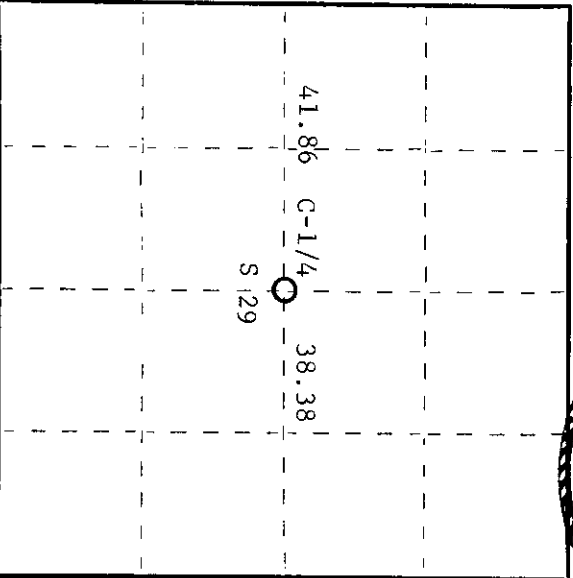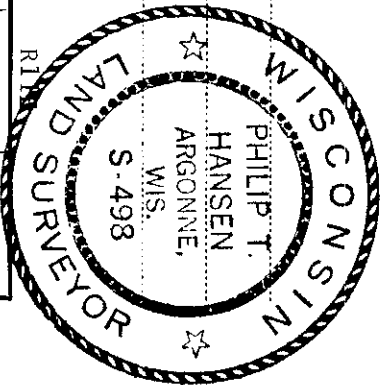

77

Index No. 7-7

History of original corner establishment:
 Corner established by D.H. Vaughan, County Surveyor, in 1906 from which cedar 14" bears N1E 62 links and hemlock 10" bears S33-1/2W 44 links
 Corner reestablished by H.C. Lawrence, Reg. Land Surveyor, in 1951. He was unable to find the corner post. Fire had burned in this area, he was able to recover a burned cedar stump, from which he set a stake, which checked out to a decayed hemlock S34°W 44 links. This point checked out with Vaughan's recorded measurement of 38.78 chains east to 1/4 corner.
 Set NBT - White Birch 6" S23°E 7-1/2 links
 Cedar Stump 14" N1E 62 links

Description of corner evidence found:

Recovered Lawrence's 4" cedar post, squared and scribed C $\frac{1}{2}$, S29, C $\frac{1}{2}$ in poor condition. A 1-1/4 O.D. iron pipe had been placed beside the cedar post which had been broken off, but point remained in the ground.

Recovered White Birch 9" S22°E 8.4 links scribbling grown over

Description of monument and accessories I established to perpetuate the original location of this corner.

Replaced wooden post with 2-1/2" x 5' galvanized iron pipe w/brass cap stamped -

NBT Red Maple - 6" N41°E 20.3 links scribed 1/4 BT

S498
 T37N R11E
 C-1/4 S 29
 GPI-1975

Dated at Rhinelander, Wis., this 1st day of April, 1975.

Signature: *Philip T. Hansen* Title: Reg. Land Surveyor Registration No. S-498
 County Surveyor, Registered Land Surveyor or other duly authorized official

Office of Register of Deeds, County of Oneida, I hereby certify that the within instrument was filed in this office for record on the 1st day of October, 1975 at 3:00 o'clock P.M.

Donna Verage Tuelke
 (Register of Deeds)

○ = Corner monument restored.

By: _____ Deputy

3711292020