

CERTIFIED LAND CORNER RESTORATION

59 Index No. S-9

State of Wisconsin } ss.


County of Oneida

I Phillip T. Hansen do hereby certify that on the 30th day of April, 1975, I found

evidence of the N-1/16 corner of Sections 28 and 29 Township 37 North, Range 11 East, Fourth Principal Meridian,

as described hereon; and that from this evidence I established a new monument and accessories as described hereon to perpetuate the original location of this corner.

Resident witnesses:

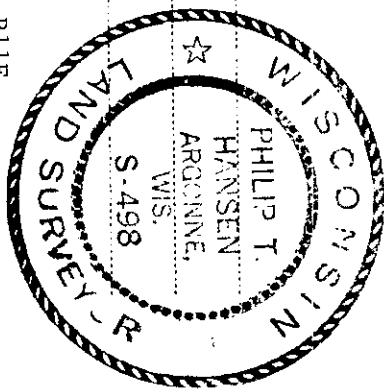

T37N, R11E

19.80			
19.78	N-1/16		
		S 28	

○ = Corner monument restored.

History of original corner establishment:

Original corner established by Wm. E. Dougherty, Gov. Deputy Surveyor, in 1859. BT's - Tamarack 6" bears N40°W, 30 links; tamarack 7" bears N65°E, 18 links. Corner set by V.M. Maine, County Surveyor, in 1937; established BT - white pine stump 38" N30°W, 91-1/2 links; white pine stump 26" S60°W, 29 links.

Corner restored by H.C. Lawrence, Registered Land Surveyor, during his retracement survey in 1949. Recovered V.M. Maine's corner and BT intact. Set new cedar post and established BT's - Aspen 12" N20°W, 6 links; elm 12" (group of four) S25°W, 69 links.

Description of corner evidence found:
 Recovered 5" cedar post, squared and scribed S28 N-1/16 S29, in poor condition.
 Also, a 1-1/2" iron pipe sitting beside the wood post.
 Recovered elm 12"(13) S25°W, 69 links, scribing grown over.
 Aspen 12" N20°W, 6 links (7.5 links), scribed N-1/16 S29.

Description of monument and accessories I established to perpetuate the original location of this corner.

Extracted point of wooden post and replaced it with a 1-1/2" O.D. x 5' iron pipe with 2" brass cap stamped - S498
 Established new BT - white birch 6" S53°E 16 links, T37N, R11E
 scribed 1/16 BT. N-1/16 S29 | S28
 CPT-1975

Dated at Rhinelander, Wis., this 20th day of May, 1975.

Signature *Phillip T. Hansen* Title Registered Land Surveyor Registration No. S-498
 (County Surveyor, Registered Land Surveyor, or other duly authorized official)

Office of Register of Deeds, County of Oneida I hereby certify that the within instrument was filed in this office for record on the 1st day of October, 1975 at 3:00 o'clock P.M.

Doris Savage Tuelin
 (Register of Deeds)

By Deputy

3711293000