

CERTIFIED LAND CORNER RESTORATION



State of Wisconsin }
 County of Oneida } ss.

I, Philip T. Hansen, do hereby certify that on the 2nd day of September, 1975, I found evidence of the Quarter corner of Section 34 and 35 Township 37 North, Range 11 East, Fourth Principal Meridian, as described hereon; and that from this evidence I established a new monument and accessories as described hereon to perpetuate the original location of this corner:

Description of original monument and accessories and subsequent restorations: Original corner established by Wm. E. Dougherty, Gov. Deputy Surveyor in 1859, from which Fir 7" bears N 55° W 7 lks and Fir 10" bears N 60° E 10 lks. Corner recovered and restored by J.J. Melendy, Gagen Lbr Co. Surveyor in 1916. Corner recovered by V.M. Maine, County Surveyor in 1935. Set a 2½" iron pipe w/brass cap in place of Melendy's post. Corner recovered by H.C. Lawrence Registered Land Surveyor in 1952. Set new cedar post, corner sets in camp site. Established BC - SW cor. Cook camp N 60° W 94 lks, SE corner of barn, N 44° W 129 lks NE corner, Blacksmith Shop N 73° W 31½ lks.

Description of corner evidence found: Recovered cedar post, squared and scribed ¼ S S34, ¼ S S 35, in good condition. Also recovered 2½" iron pipe w/brass cap stamped. Buildings of old camp site are all gone. Holes, made by earth banks around building only evidence remaining.


T 37 R 11
 1/4
 S 34 S 35
 M

Description of monument and accessories I established to perpetuate the location of this corner:

The iron pipe was straight and well set, so was left in place. Also left Lawrence's post setting beside it.

NBTs Sugar maple 10" S 47° W 96.2 lks scribed ¼ BT
 Sugar maple 10" S 59° E 126.3 lks " " "
 Bearings and distances to iron pipe

T 37 N R 11 E

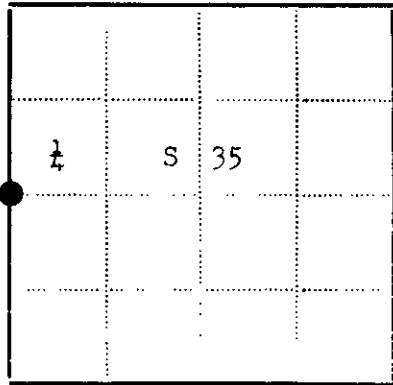

● - Corner monument restored
 □ -

Resident witnesses Glen Barker and Jim Claflin

Dated at Rhinelander Wisconsin, this 16 day of September 1975

Signature Philip T. Hansen Title Reg. Land Surveyor
 (County Surveyor, Registered Land Surveyor, or other duly authorized official)

Surveyors Registration No. S 498

Office of Register of Deeds County of Oneida

I hereby certify that the within instrument was filed in this office for record on the 14th day of October, 1975, and was filed in Book No. _____ Page No. _____ of County Records.

Signature Doris Verage Kuehn Title Register of Deeds

Township 37 North, Range 11 East, Section 35, Index No. _____, Page No. _____

3711342600

X-17