

CERTIFIED LAND CORNER RESTORATION

Index No. A-23

State of Wisconsin

County of Oneida } ss.

History of original corner establishment:
Original corner established by Wm. E. Dougherty in 1859.

I Philip T. Hansen do hereby certify that on the 11th day of December 19 74, I found evidence of the S36 1/4 corner of S1 and S6 Township 36 - 37 North, Range 11 E, Fourth Principal Meridian,


Corner replaced with iron pipe by V.M. Maine, County Surveyor, in 1938.

Hemlock 6"	N13W	12 links
Hemlock 8"	S65E	9 links
Hemlock 6"	N50E	26 1/2 links
Maple 9"	S62W	46 links

as described hereon; and that from this evidence I established a new monument and accessories as described hereon to perpetuate the original location of this corner.

Description of corner evidence found:


Recovered H.C. Lawrence 4" hemlock post, squared and scribed S1-1/4 S36-1/4. In his re-tracement survey of 1957, he found V.M. Maine's corner in error. From his notes ran the line east from the corner of Section 1-2-35 and 36 and located the corner set by V.M. Maine. As the original survey called for hemlock BT's and as there was an abundance of hemlock stumps, one chain north, he carefully examined the old stumps and found an old 18" stump with the original scribes and notch deep inside and well preserved and intact, which conformed to the hemlock 8" S65E 9 links noted above. The hemlock 6" N13W 12 links was gone, but a depression indicated it had blown down. He set a new 4" hemlock post 5" on the same bearing and distance as the original notes and marked new bearing trees. Yellow birch 20", N35E, 13 links - Sugar 8", S22W, 12 links. From this corner Maine's Corner bears South 16 East, a distance of 96 links. Description of monument and accessories I established to perpetuate the original location of this corner. Set 2-1/2" x 5' galvanized iron pipe with brass cap stamped - S498

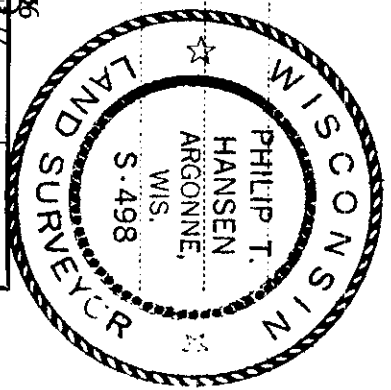

Set new BT, Sugar maple 7", N8E, 12 links. Recovered old BT.

Yellow birch stump 20"	N35E	13 links	T36N R11E
Hemlock stump (old)	S76E	9 1/2 links	CPI-1974
High point on boulder	N67W	12 links	

S36 1/4 S1

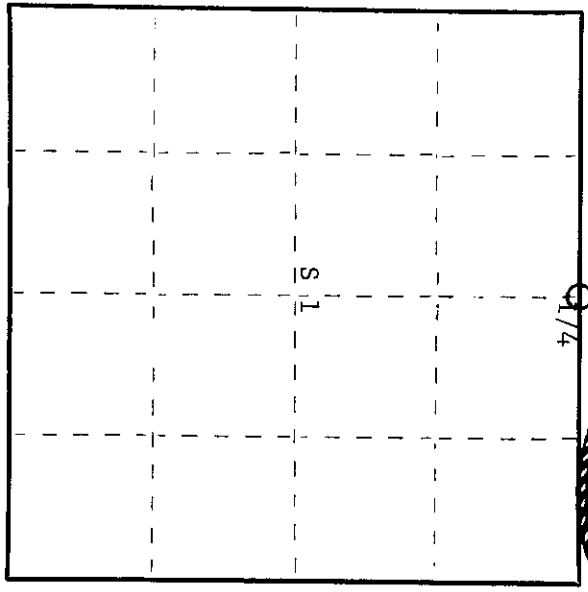

Dated at Rhinelander, Wis., this 11th day of December, 19 74.

Signature: *Philip T. Hansen* Title: Registered Land Surveyor Registration No. S-498
(County Surveyor, Registered Land Surveyor, or other duly authorized official)

Office of Register of Deeds, County of Oneida. I hereby certify that the within instrument was filed in this office for record on the 1st day of October, 19 75 at 3:00 o'clock P.M.

Doris Inge Funder
(Register of Deeds)

By: Deputy

02000360020