

CERTIFIED LAND CORNER RESTORATION

Index No. 38-413

State of Wisconsin

County of Pike } ss.

I Flwood L. Olson, do hereby certify that on the 2nd day of January, 1961, I found evidence of the Section corner of Sections 1-6-7-12 Township 38, North, Range 3 and 4 East, Fourth Principal Meridian,

I established a new monument and accessories as described hereon to perpetuate the original location of this corner.

Resident witnesses:

History of original corner establishment:
Original corner established in 1864 by Alex Anderson, Government Deputy Surveyor.
 Hemlock 10 N60° 34 1/2 links
 " 9 N48° 36 "
 Birch 14 S35° 37 "
 " 15 S70° 23 "

874-9 form by Harry L. Sykes dated 1/3/1936. There are two witness trees, both down but the scribbling is still legible.
 T. Birch 12° S70W, 23 lks. mkd. T38NRJES12.
 Hemlock 11° N48E, 20 lks. mkd. T38NRJES6.
 Metal location poster on 10° Balsam which bears N39E, 20 feet.


Description of corner evidence found:

Corner marked by a 3" squared cedar post. Found old cedar post laying on ground. First Sykes location tag on fallen Balsam 15" dia., which bears N79E, 20 feet to stump.
 Check for the original bearing trees and found:
 Stump hole and decayed Hemlock windfall, bears N48E, 20 links, as called for by Sykes.
 Decayed Birch stump and fallen decayed Birch bears S70W, 23 links (record).
 The corner is about 35 ft. SW of a swamp.

Description of monument and accessories I established to perpetuate the original location of this corner.

Set 2" inside dia., 5' long, flanged bottom, concrete filled, galvanized wrought iron pipe with 3" bronze tablet stamped: T38N, R3E, S1, S6, S7, S12, S.785, 1964. Monument set 9' above ground. Set cedar post, top foot painted red, 3 1/2 feet N. of monument.
 Blazed and scribed new bearing trees as follows:
 Maple 5" S78°W, 41.8 feet, mkd. ⊗ N7 BT.
 Cedar 13" S59°E, 78.5 feet, mkd. ⊗ N7 S7 BT.
 Cedar 10" N59°30'W, 39.5 feet, mkd. ⊗ N7 S1 BT. (Loc. tags also loc. tag by Conservation Dept. on this tree.)
 Nail set-1 BT. sign on all BTs. Paint N7S red.

T38N R3E

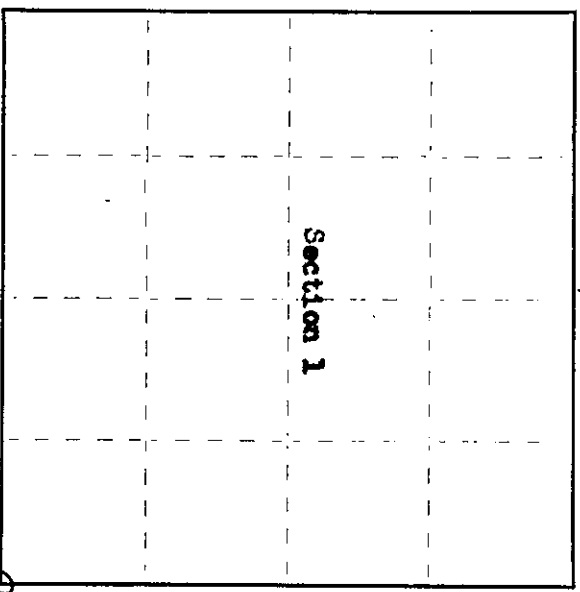


○ = Corner monument restored.

Dated at Park Falls, Wis., this 6th day of March, 1961

Signature Flwood L. Olson Title Registered Land Surveyor
 (County Surveyor, Registered Land Surveyor, or other duly authorized official)

Office of Register of Deeds, County of _____ day of _____ 1961
 Instrument was filed in this office for record on the _____ day of _____ 1961
 at _____ o'clock _____ M.

(Register of Deeds)

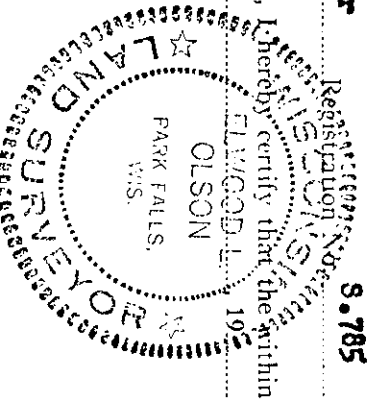

By _____ Deputy