


U.S. PUBLIC LAND SURVEY MONUMENT RECORD

Note: This form is intended and designed to fulfill all requirements of Wisconsin Administrative Code, Chapter A-E 5.02, U.S. Public Land Survey Monument Record (3) (a) (b) (c) (d) (e) (f) (g) (h) (i). An additional sheet may be added if necessary to conform with said requirements.

(a) Corner location: Township 38 North
 Range 4 East/West

Town/City/Village Minocqua
 County Oneida

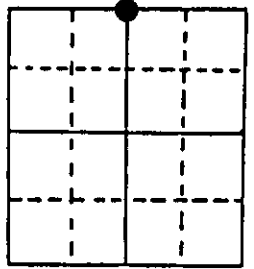

Section 27


(b) (f) (g) (h) Description of monument found at this corner and if it was accepted, state all evidence (material, testimonial, occupational, plats, records, other monuments) used as a basis for accepting. If not accepted or if nothing was found, state evidence used as basis for establishing location. If reestablished through lost corner proportionate methods, indicate all monuments, distances and directions used to establish.

The original Government Survey was performed by Alexander Anderson in April & May, 1865. A wood post was set: W. Pine 12" N80E, 7 lks., Hemlock 9" N83W, 7 lks.

After establishing a search area from our traverse information, I searched the area extensively and found no marks of the original or any other surveyor. I therefore established at proportionate measure: Aluminum Pipe, 30" long, 2 1/2" dia. 24" in the ground with aluminum cap stamped as shown below. The NW corner of the section bears: S88 26'46"W, 2627.32 feet. The NE corner of the section bears: N88 26'46"E, 2627.32 feet (see U.S.P.L.S. mon. records). I established the following witnesses: Cedar 9" N26W, 69.03'; Cedar 8" N23W, 41.32'; Cedar 12" N54E, 53.57'; Cedar 7" N61E, 32.70'; Tamarack 10" S51E, 60.88'; set plastic survey marker sign N10E, 1'.

(c) (d) (e) Plan view of corner with ties to at least 4 witness monuments. If in disagreement with previously established corner, show the distances between the two corners and also indicate the ties to the disputed corner.

REGISTER OF DEEDS OFFICE
 ONEIDA COUNTY, WIS
FILED
 FEB 16 1989
 At _____ O'Clock _____ M
THOMAS H. LEIGHTON
 REGISTER OF DEEDS

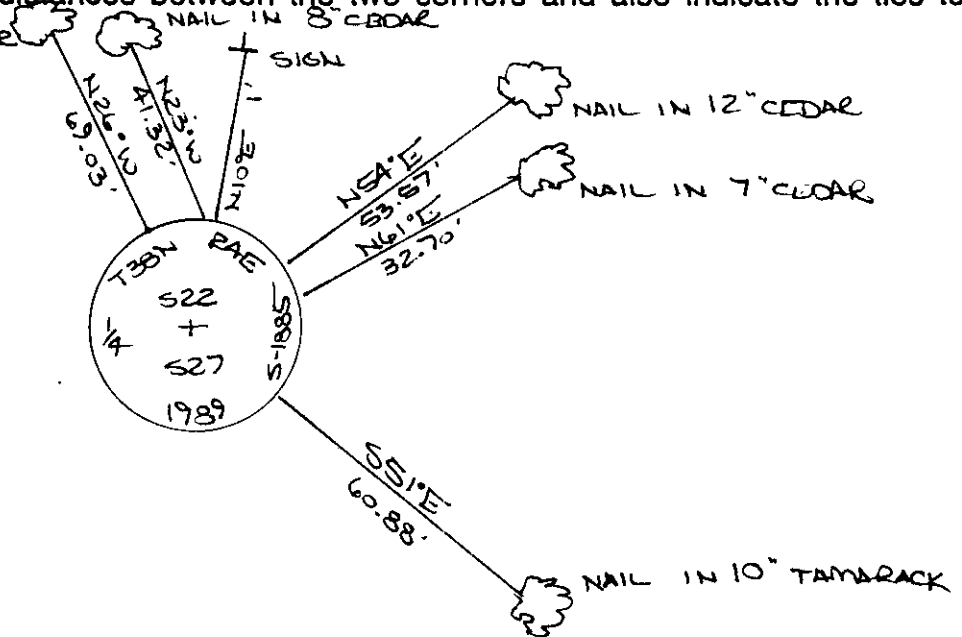

(i) I, JEFFREY W. AUSTIN S-1885
 (type or print name) certify that the corner location on this record was determined by me or under my direction and control and that this U.S. Public Land Survey Monument Record is correct and complete to the best of my knowledge and belief.

Jeffrey W. Austin Signature Date FEBRUARY 1, 1989



Index No. P-15