

U.S. PUBLIC LAND SURVEY MONUMENT RECORD


Note: This form is intended and designed to fulfill all requirements of Wisconsin Administrative Code, Chapter A-E 7.08 U.S. Public Land Survey Monument Record (3) (a) (b) (c) (d) (e) (f) (g) (h) (i). An additional sheet may be added if necessary to conform with said requirements.

(a) Corner location: Township 38 North

Range 4 East/~~West~~

Town/City/Village MINOCQUA

County ONEIDA

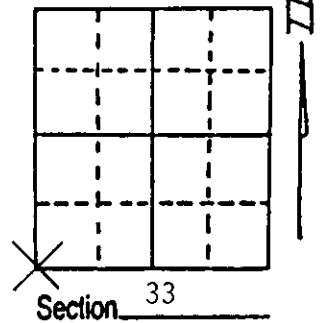


(b) (f) (g) (h) Description of monument found at this corner and if it was accepted, state all evidence (material, testimonial, occupational, plats, records, other monuments) used as a basis for accepting. If not accepted or if nothing was found, state evidence used as basis for establishing location. If reestablished through lost corner proportionate methods, indicate all monuments, distances and directions used to establish. Indicate type of monument found or set and sign post.

Original Government Survey performed by Alexander Anderson, April & May, 1865. Post set. Birch, 20", N72°W, 28 Links; Sugar, 12", N41°E, 21 Links; Sugar, 10", S30°E, 15 Links; Lind, 18", S42°W, 17 Links.

In 1961, W.H. Stuth working for NEPCO, found a Iron pipe with brass cap, for corner.
In 1989, this corner was marked with a white cross for aerial photo.

On August 9, 1994, I found a 1½" Iron Pipe with no cap, remains of white plastic forming cross over Pipe, a 4x4 Cedar post with Section Numbers scribed on it. Removed pipe, left it laying by Oneida County Aluminum Monument that I set as Section Corner. Distance to Meander Corner to the East matches Stuth distance within 0.2', matches Stuth distance to NW Corner by 0.8'. Held as corner. Searched 100 foot radius for any other evidence, found none. Set fiberglass warning sign on South side of corner. Tied out, painted everything yellow.

(c) (d) (e) Plan view of corner with ties to at least 4 witness monuments. If in disagreement with previously established corner, show the distances between the two corners and also indicate the ties to the disputed corner.

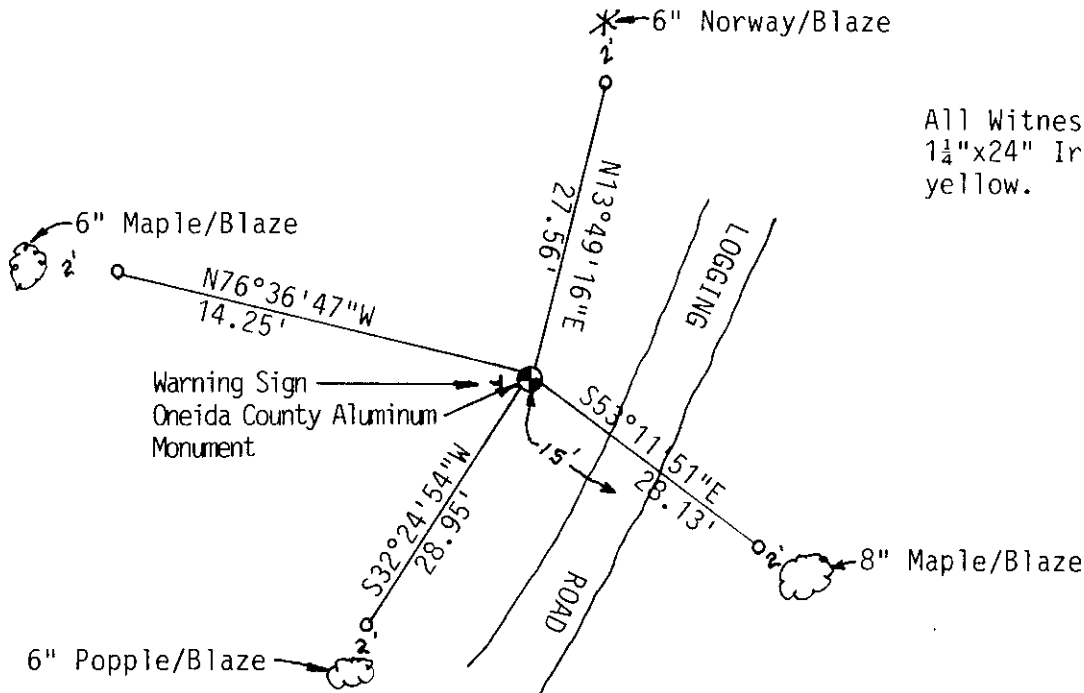

All Witness Corners are 1¼"x24" Iron Pipe, painted yellow.

(i) I, David L. Osterbrink RLS No. S-2014
(type or print name) certify that the corner location on this record was determined by me or under my direction and control and that this U.S. Public Land Survey Monument Record is correct and complete to the best of my knowledge and belief.

David L. Osterbrink 9-21-94
Signature Date



3804320000
Stamp

Index No. Z-9