

CERTIFIED LAND CORNER RESTORATION

Index No. E-13

History of original corner establishment:  
The original Gov't. Survey was performed by Alexander Anderson, Deputy Surveyor in June 1863

Set Wood Post  
8" Birch N52-1/2 W 80 links  
8" Maple S23-1/4 W 20 links

Description of corner evidence found:  
6" X 6" concrete monument

State of Wisconsin

Oneida } ss.

I John H. Fisher, do hereby certify that on the 28 day of February 19 83, I found evidence of the Northwest corner of Section 10 Township 38 North, Range 6 East, Fourth Principal Meridian, as described hereon; and that from this evidence I established a new monument and accessories as described hereon to perpetuate the original location of this corner.

Resident witnesses:  
None

Description of monument and accessories I established to perpetuate the original location of this corner.  
Used Concrete Monument as found.

Witness Corners:

2" Iron Pipe	N84° 26' 127" E	131.25 feet
2" Iron Pipe	N84° 26' 127" E	33.00 feet
3/4" Iron Rod	S6° E	10.00 feet
3/4" Iron Rod	S74° E	10.00 feet
11" Maple	N17° E	15.3 feet
6" Maple	N31° W	15.6 feet


Dated at Minocqua, Wis., this 28 day of May, 19 83.

Signature: *Arthur B. Fisher* Title: Registered Land Surveyor Registration No. \_\_\_\_\_  
(County Surveyor, Registered Land Surveyor, or other duly authorized official)

Office of Register of Deeds, County of \_\_\_\_\_, I hereby certify that the within instrument was filed in this office for record on the \_\_\_\_\_ day of \_\_\_\_\_, 19 \_\_\_\_\_ at \_\_\_\_\_ o'clock \_\_\_\_\_ M.

(Register of Deeds)

By \_\_\_\_\_ Deputy

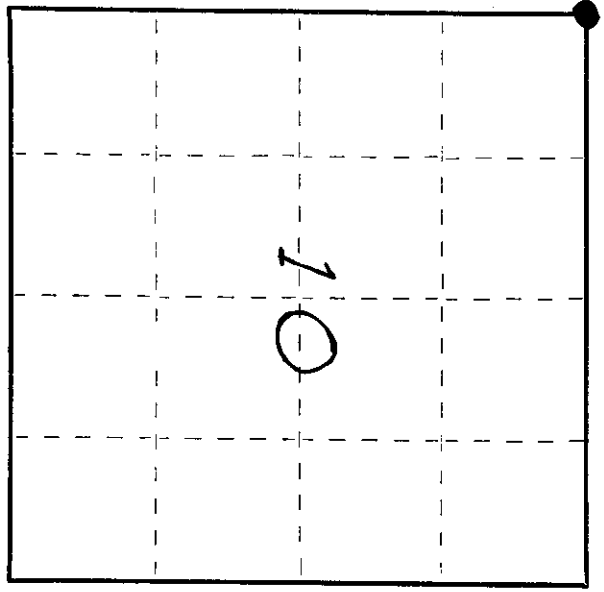

● = Corner monument restored.

(e) Describe any material discrepancy between the location of the corner as restored or reestablished and the location of that corner as previously restored or reestablished by distance and direction. Show the discrepancy on the plan view drawing under (d), above. Show the distances between the corner as previously restored or reestablished and (1) the corner as restored or reestablished, and (2) to at least 2 of the witness monuments shown on the drawing in (d), above.


None

(f) Was the corner restored through acceptance of (1) an obliterated evidence location, or, (2) a found perpetuated location?

(2)

(g&h) Was the corner reestablished through lost corner proportionate methods? If so, show the method, including the directions and distances to other public land survey corners used as evidence or used for proportioning in determining the corner location?

No

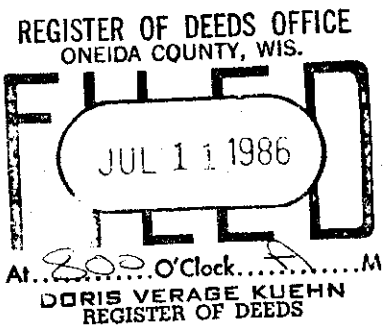

(i) I, John H. Fisher  
(type or print name) certify that the corner location shown on this record was determined by me or under my direction and control and that this U.S. Public Land Survey Monument Record is correct and complete to the best of my knowledge and belief.

John H. Fisher  
Signature

5/3/83  
Date

