U.S. PUBLIC LAND SURVEY MONUMENT RECORD

Note: This form is intended and designed to fulfill all requirements of Wisconsin Administrative Code, Chapter A-E 5.02, U.S. Public Land Survey Monument Record (3) (a) (b) (c) (d) (e) (f) (g) (h) (i). An additional sheet may be added if necessary to conform with said requirements.

(a) Corner location: Township 37 North

Range 8 East/~~West~~

Town/~~City/Village~~ Pine Lake

County Oneida

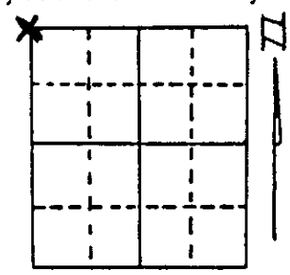

Section 2

(b) (f) (g) (h) Description of monument found at this corner and if it was accepted, state all evidence (material, testimonial, occupational, plats, records, other monuments) used as a basis for accepting. If not accepted or if nothing was found, state evidence used as basis for establishing location. If reestablished through lost corner proportionate methods, indicate all monuments, distances and directions used to establish.

September 1860, Alfred Millard set wood post for section corner:
- 8" Cedar, N2 1/2°E, 7 Links (4.62')
- 8" Cedar, S55°E, 20 Links (13.20')
- 6" Cedar, N60°W, 30 Links (19.80)
- 9" W. Birch, S9°W, 18 Links (11.88')

March 28, 1977 N. Loftus found corner and made new BT's. From County survey map #C347:
- 11" Cedar, N14°E, 16'
- 6" Cedar, S16°W, 6.1'

February 18, 1988 Milo Stefan found "RIPCO" monument, A 3" x 3" x 1/4" brass plate atop 1 1/4" iron pipe with BTs as follows:
- 10" Cedar, N15°E, 16.71'. Scribing nearly overgrown
- 6" Cedar, S22°W, 5.49'. BT blaze overgrown
- 8" Cedar, N21°W, 18.68'. Scribed "S33T38NR8E"
- Location poster on 12" Cedar, S80°W, 6.7'

(c) (d) (e) Plan view of corner with ties to at least 4 witness monuments. If in disagreement with previously established corner, show the distances between the two corners and also indicate the ties to the disputed corner.

1. "RIPCO" monument, brass plate on 1 1/2" iron pipe.
2. 10" Cedar, N15°E, 16.71'
3. 6" Cedar, S22°W, 5.49'
4. 8" Cedar, N21°W, 18.68'
5. 5" Black Ash, S44°E, 11.27' (Scribed, "T37N R8E S2 BT")
6. 12" Cedar/location poster S80°W, 6.7'
7. Plastic sign post next to monument.

Measurements to nail in side of trees.

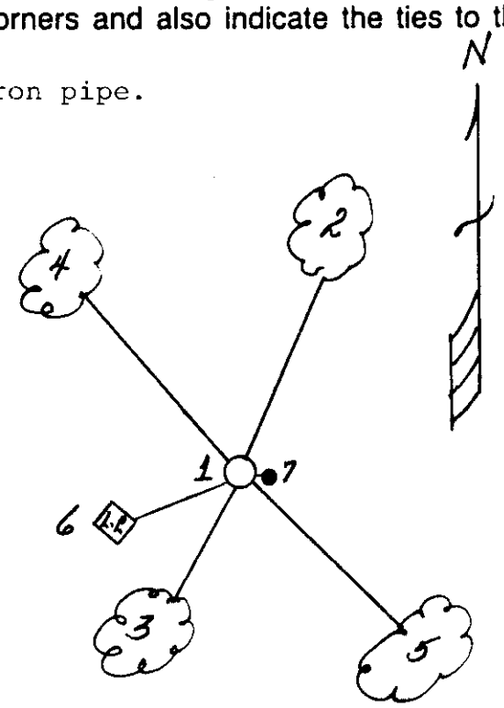

(i) I, Milo E. Stefan (type or print name) certify that the corner location on this record was determined by me or under my direction and control and that this U.S. Public Land Survey Monument Record is correct and complete to the best of my knowledge and belief.

Milo E Stefan — Signature

2/24/88 — Date

WISCONSIN MILO E. STEFAN S-1558 RHINELANDER, WIS. LAND SURVEYOR

Index No. A-17

3808340000